



1 SOUTH ELEVATION AS-BUILT
SCALE: 1/4" = 1'-0"




2 EAST ELEVATION AS-BUILT
SCALE: 1/4" = 1'-0"

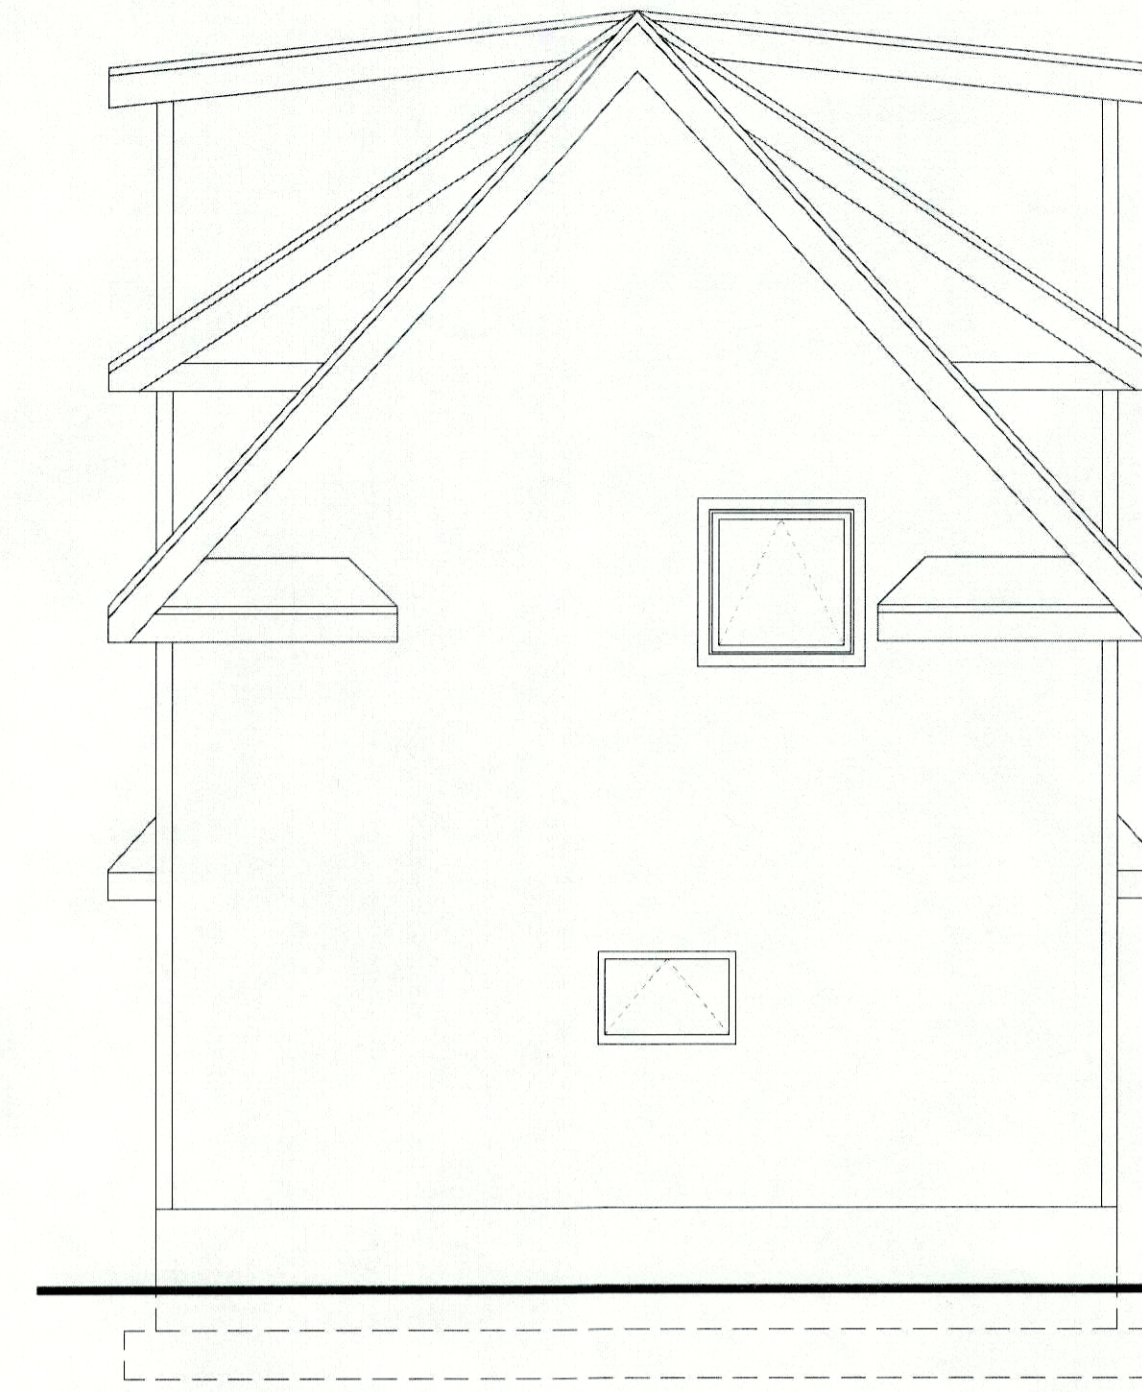


3 NORTH ELEVATION AS-BUILT
SCALE: 1/4" = 1'-0"

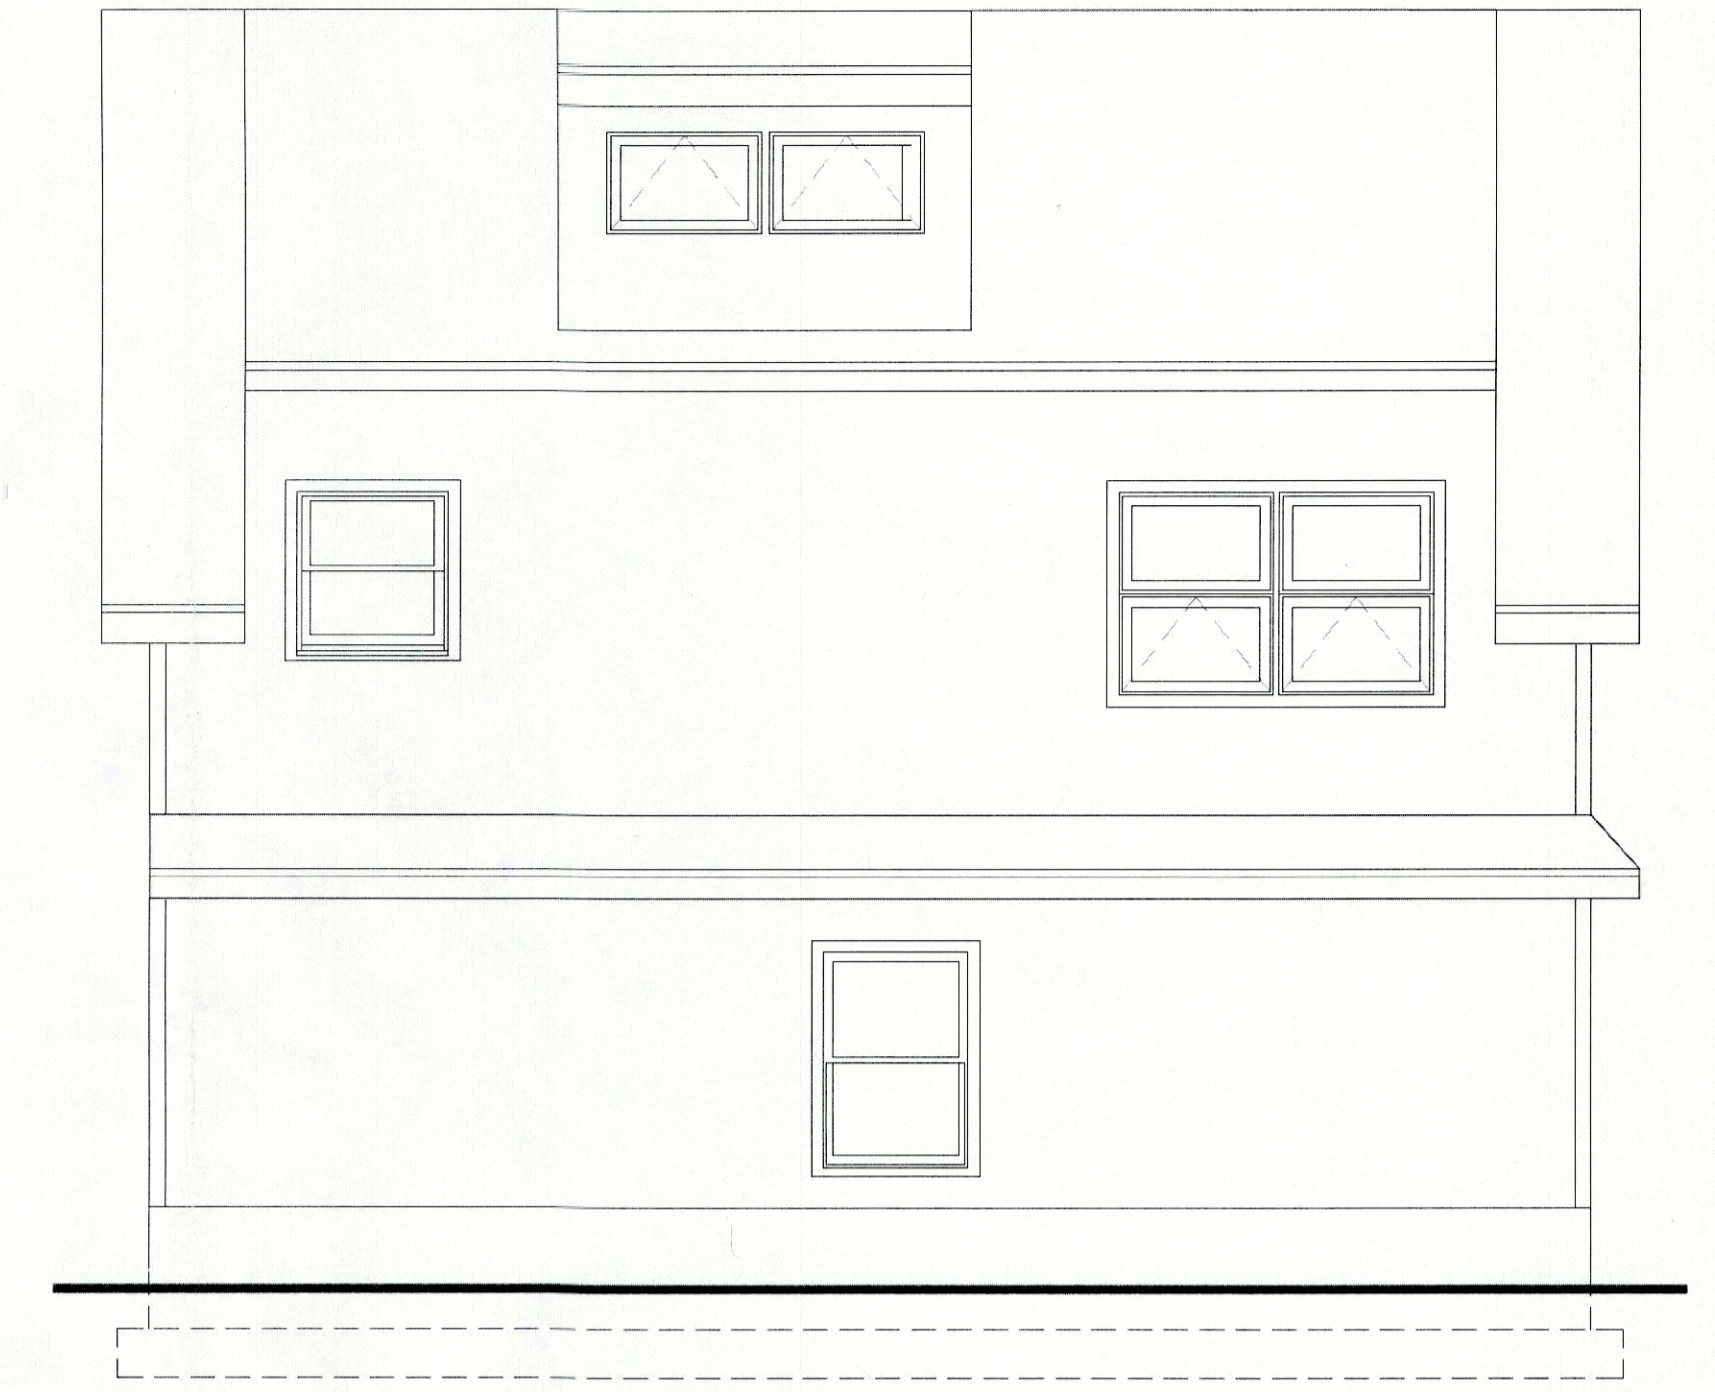


4 WEST ELEVATION AS-BUILT
SCALE: 1/4" = 1'-0"

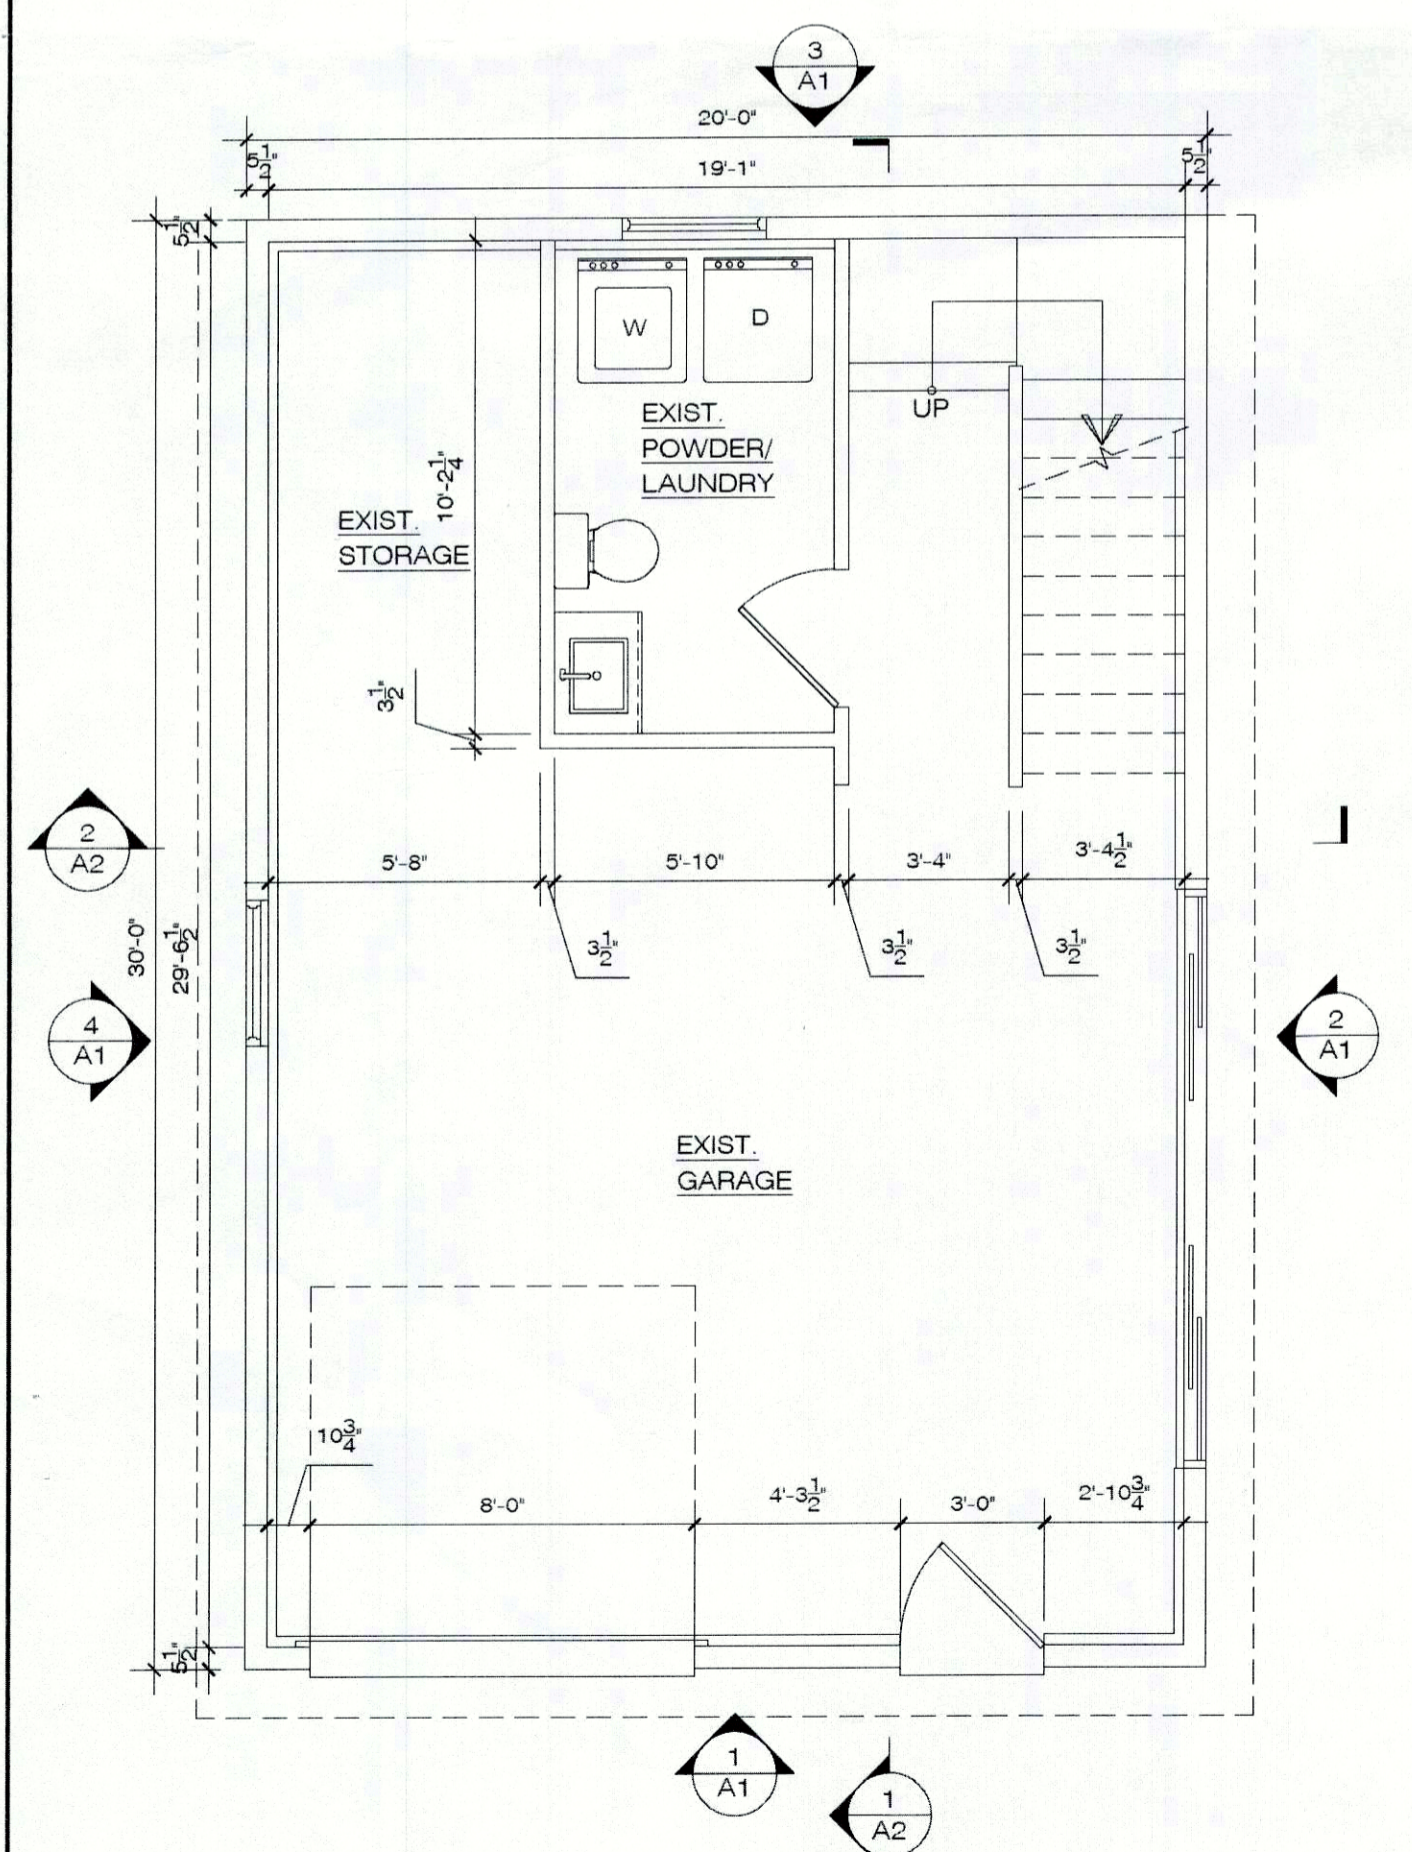


5 GARAGE FLOOR AS-BUILT
SCALE: 1/4" = 1'-0"
600 square feet

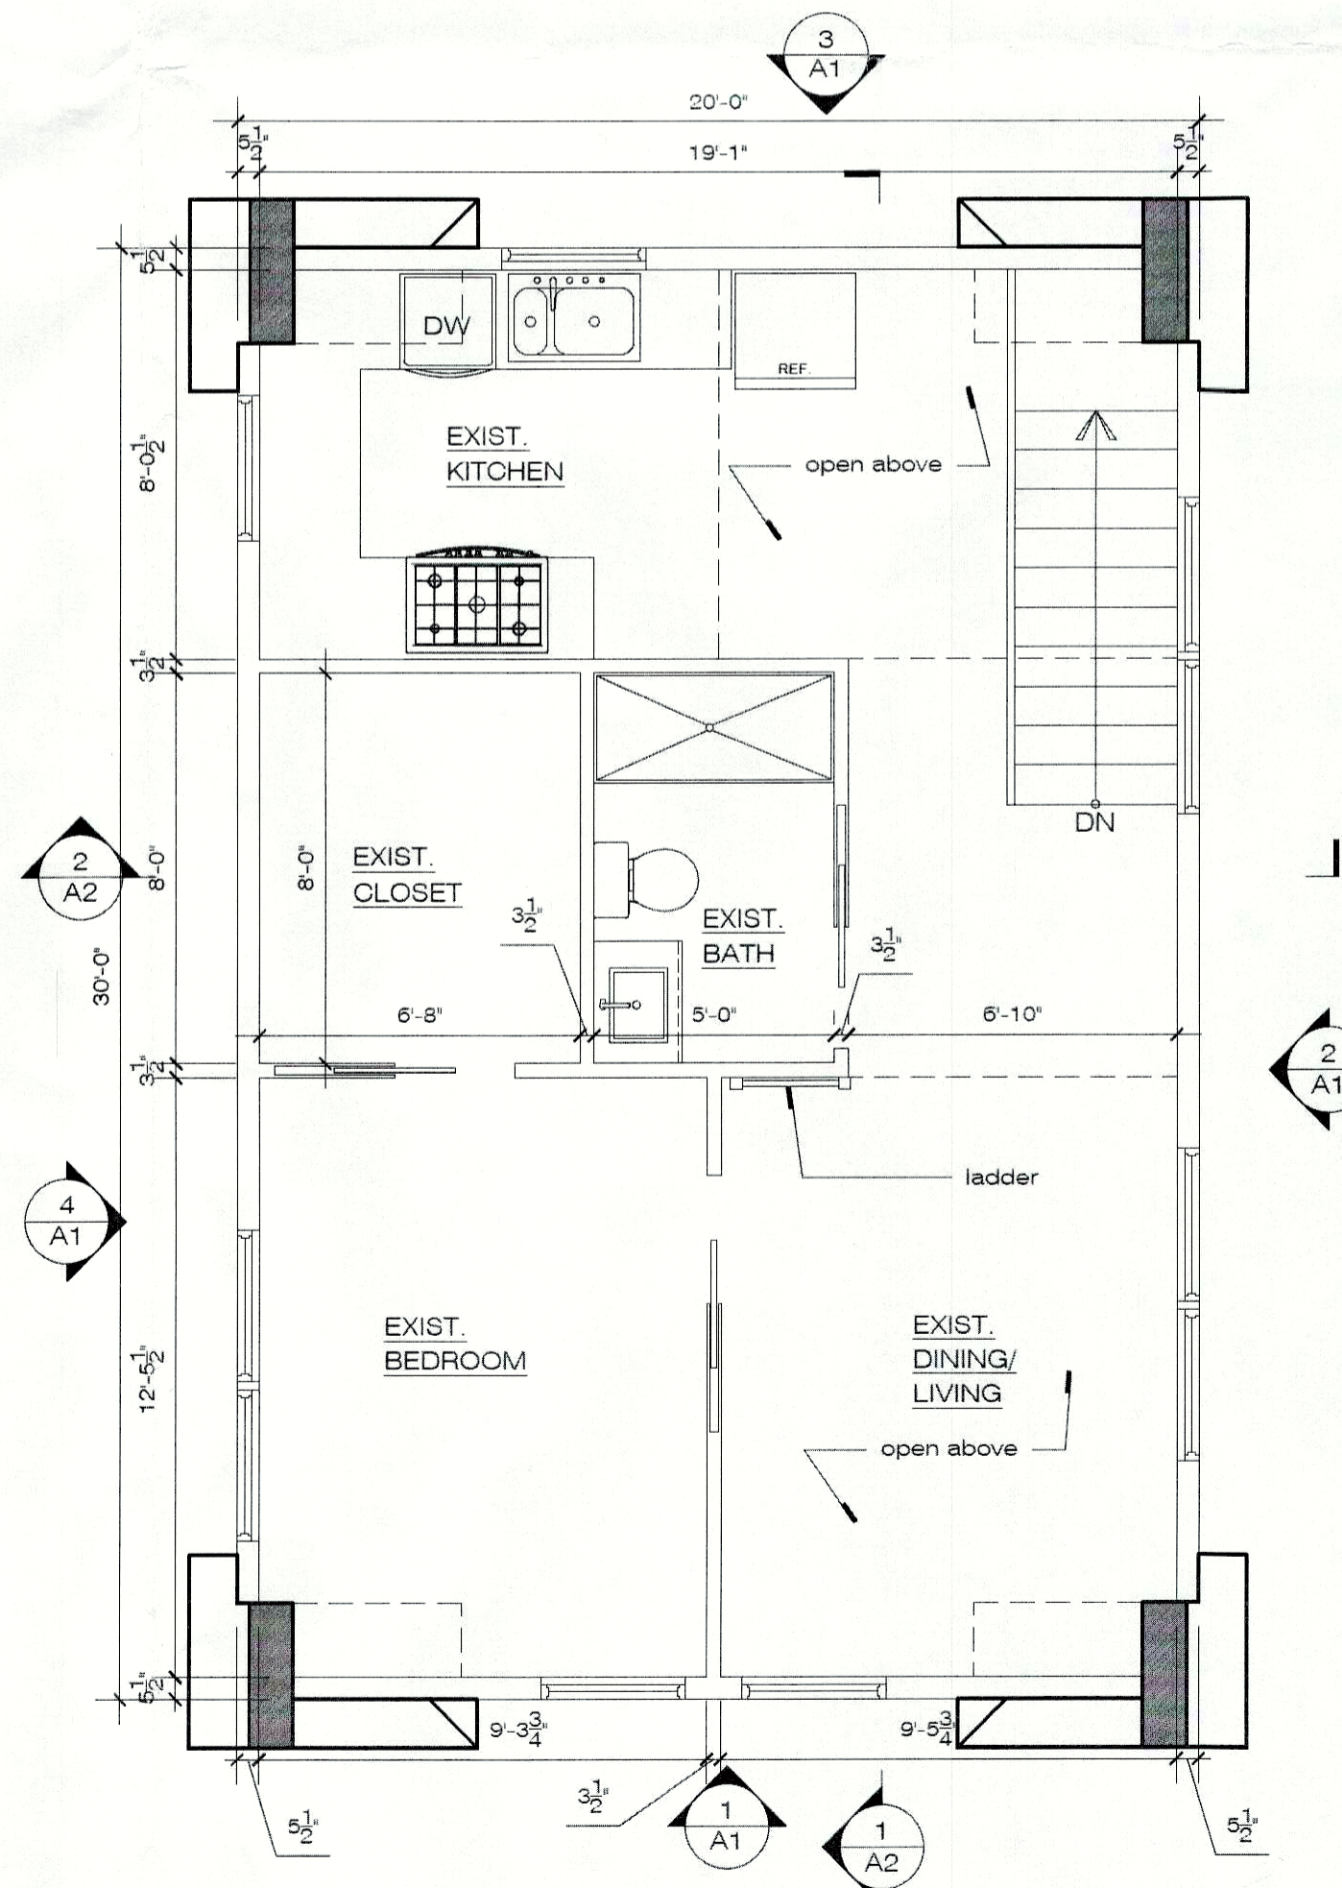

6 2ND FLOOR AS-BUILT
SCALE: 1/4" = 1'-0"
600 square feet

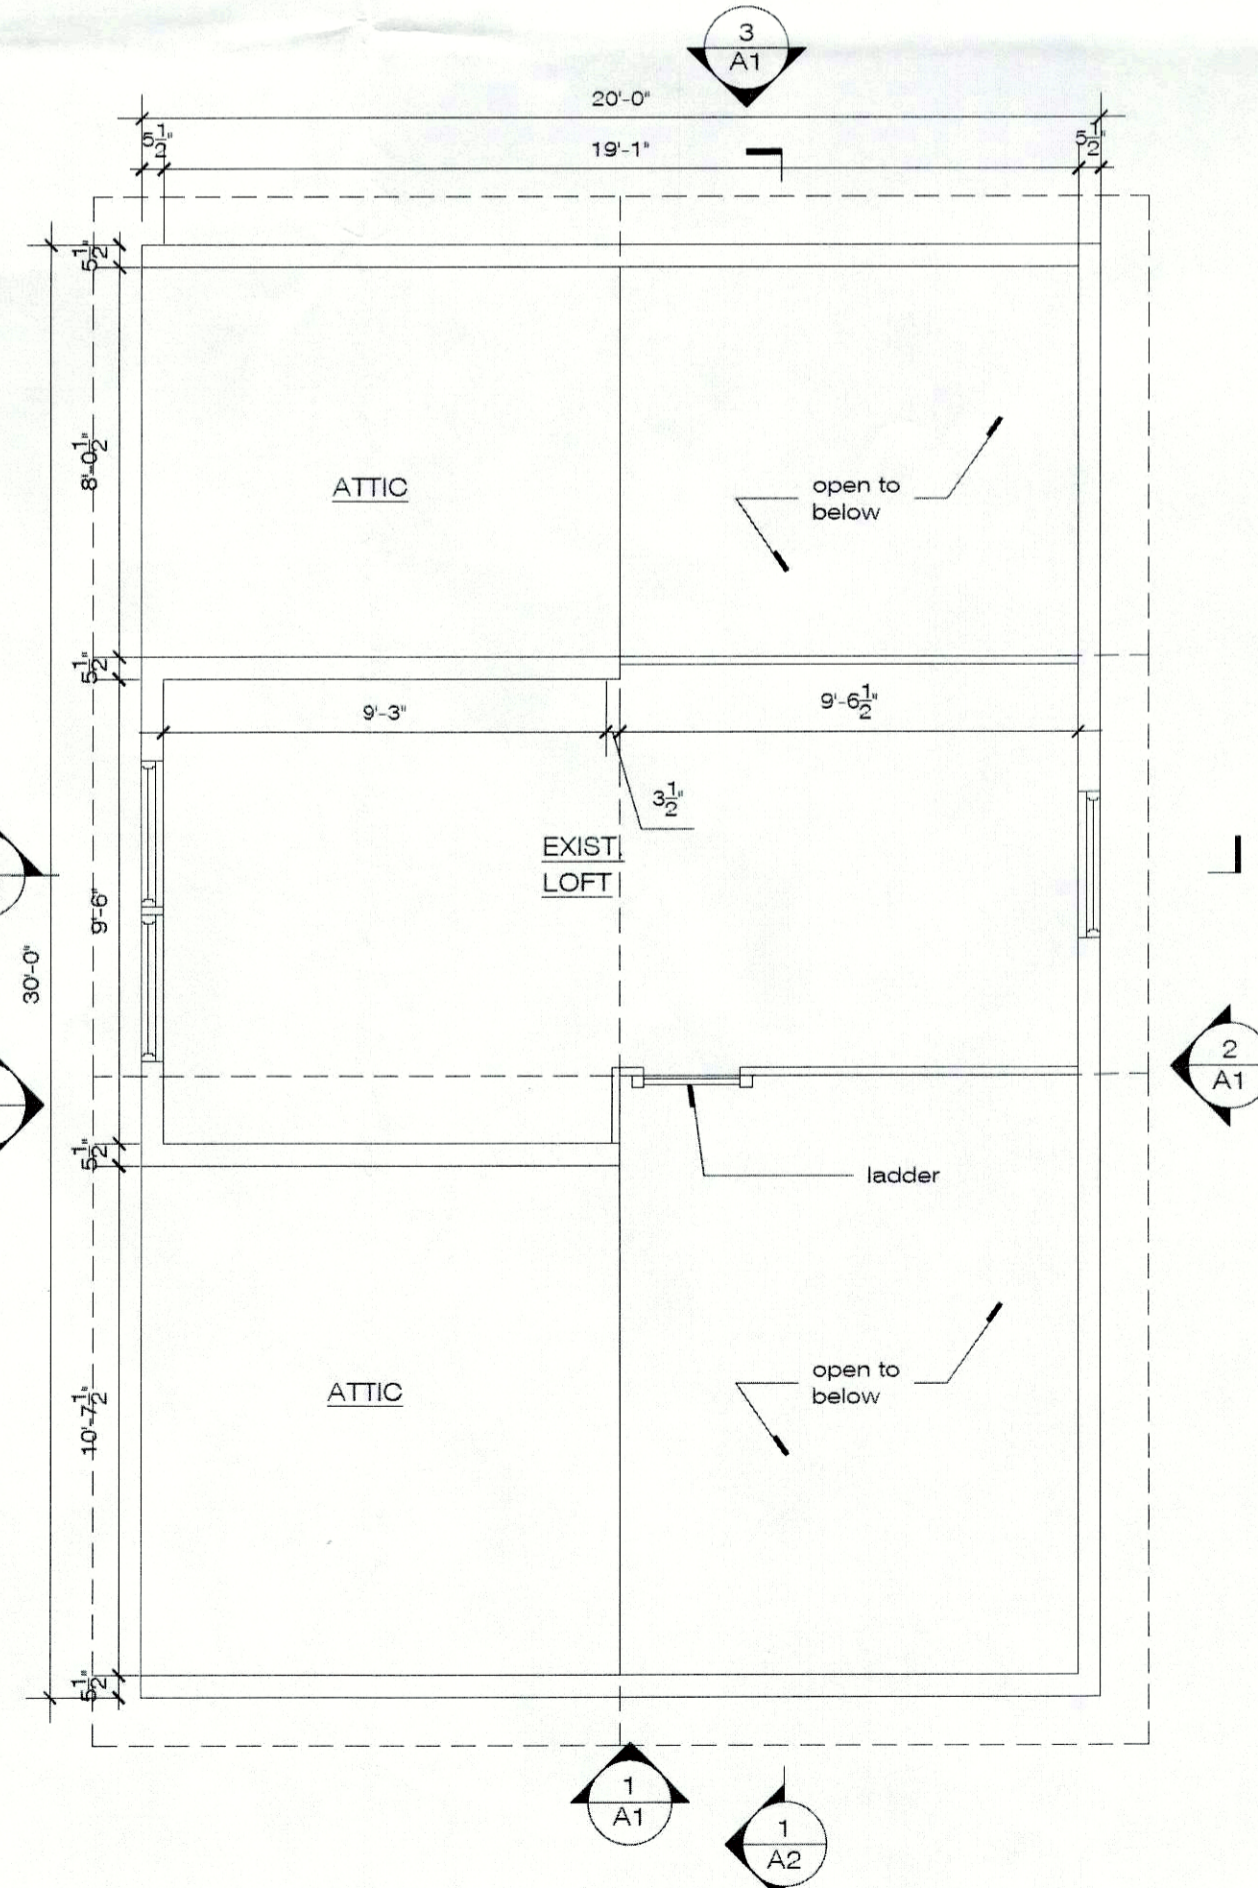


7 LOFT FLOOR AS-BUILT
SCALE: 1/4" = 1'-0"
190 square feet

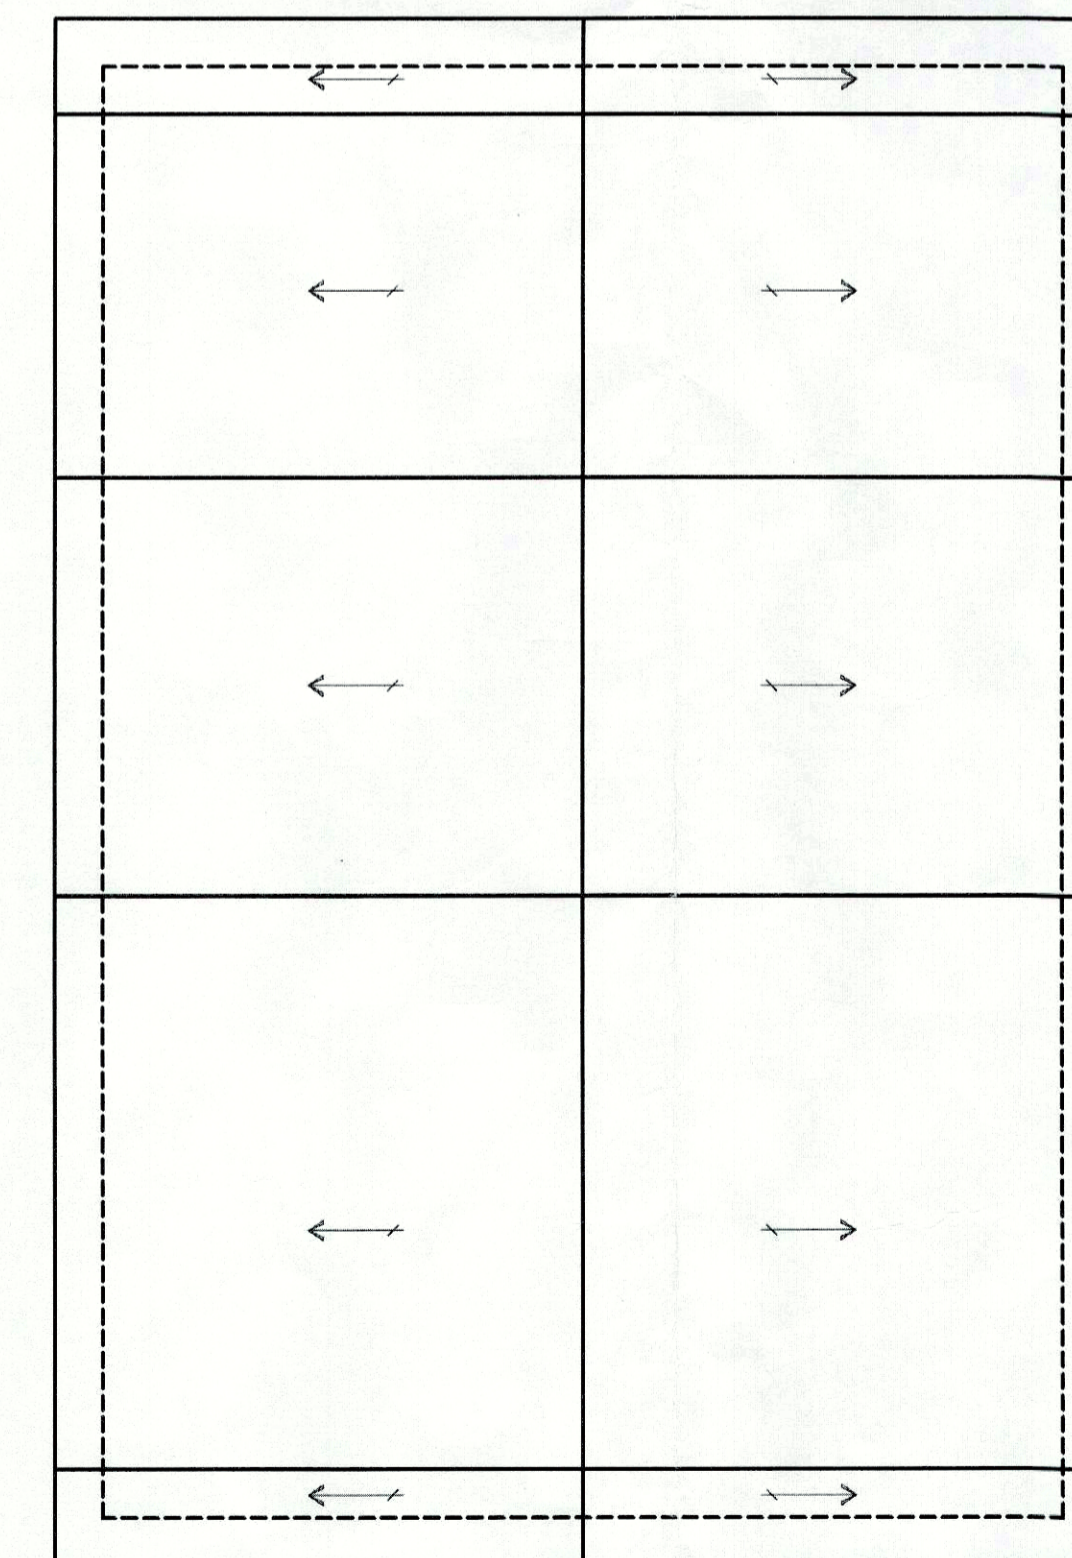

8 ROOF PLAN AS-BUILT
SCALE: 1/4" = 1'-0"

CONSTRUCTION VOLUME:
15,442 cubic feet

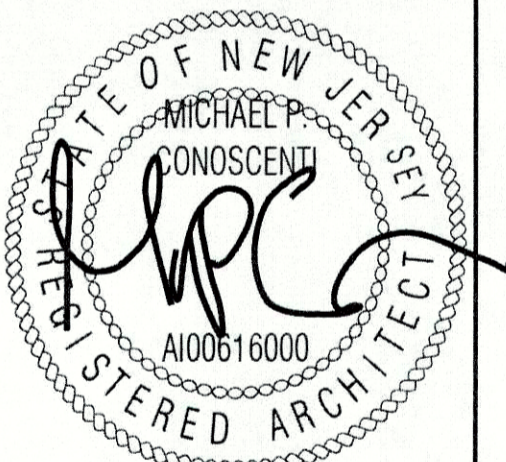

09-15-2019 - ISSUE TO ATTORNEY

MICHAEL P. CONOSCENTI, A.I.A.
ARCHITECT
123 CLIFF AVENUE
BRADLEY BEACH, NJ 07720
NJ LIC# A100616000

No.	REVISIONS DESCRIPTION	DATE


GARAGE: AS-BUILT
306 MONMOUTH AVE
BLOCK 78 LOT 14
BOROUGH OF BRADLEY BEACH,
MONMOUTH COUNTY, NJ

AS-BUILT ELEVATIONS
AS-BUILT FLOOR PLANS


PROJECT NO: 18-025
DATE: AUGUST 19, 2019
DRAWN BY: ESG
CHECKED BY: MPC

A1


SCALE: AS NOTED

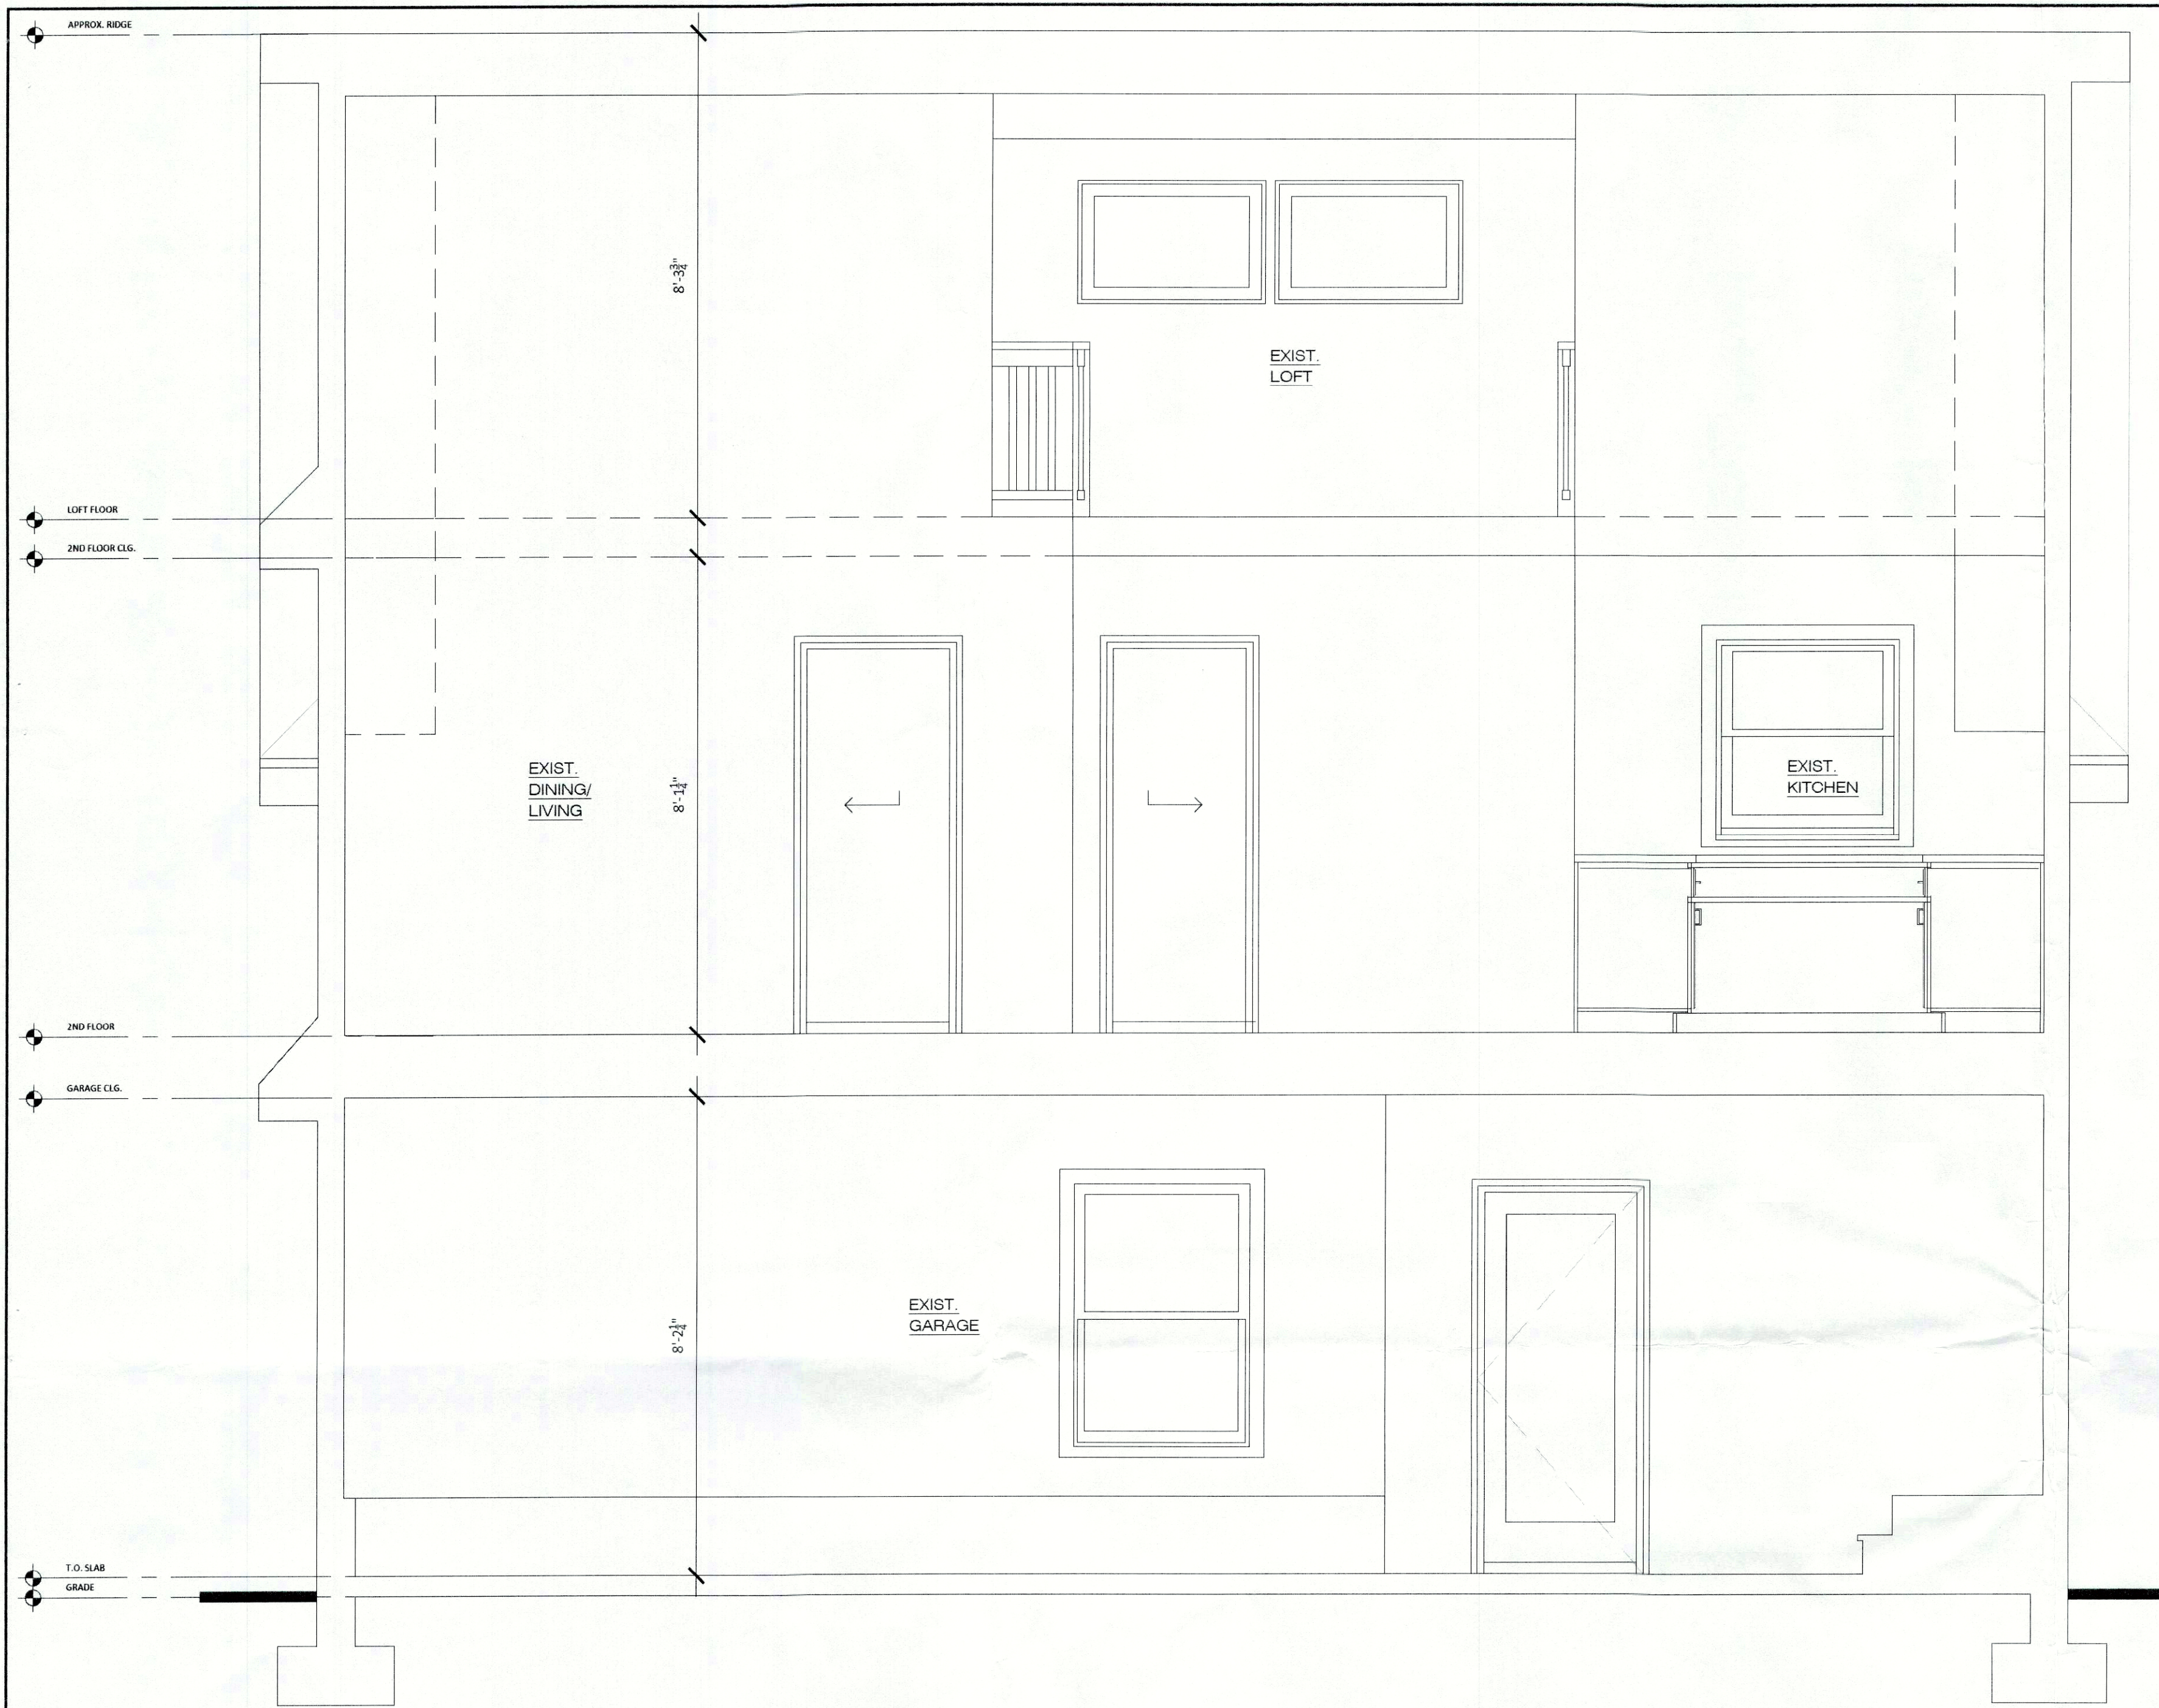

1 LONGITUDINAL SECTION
 A2 SCALE: 1/4" = 1'-0"

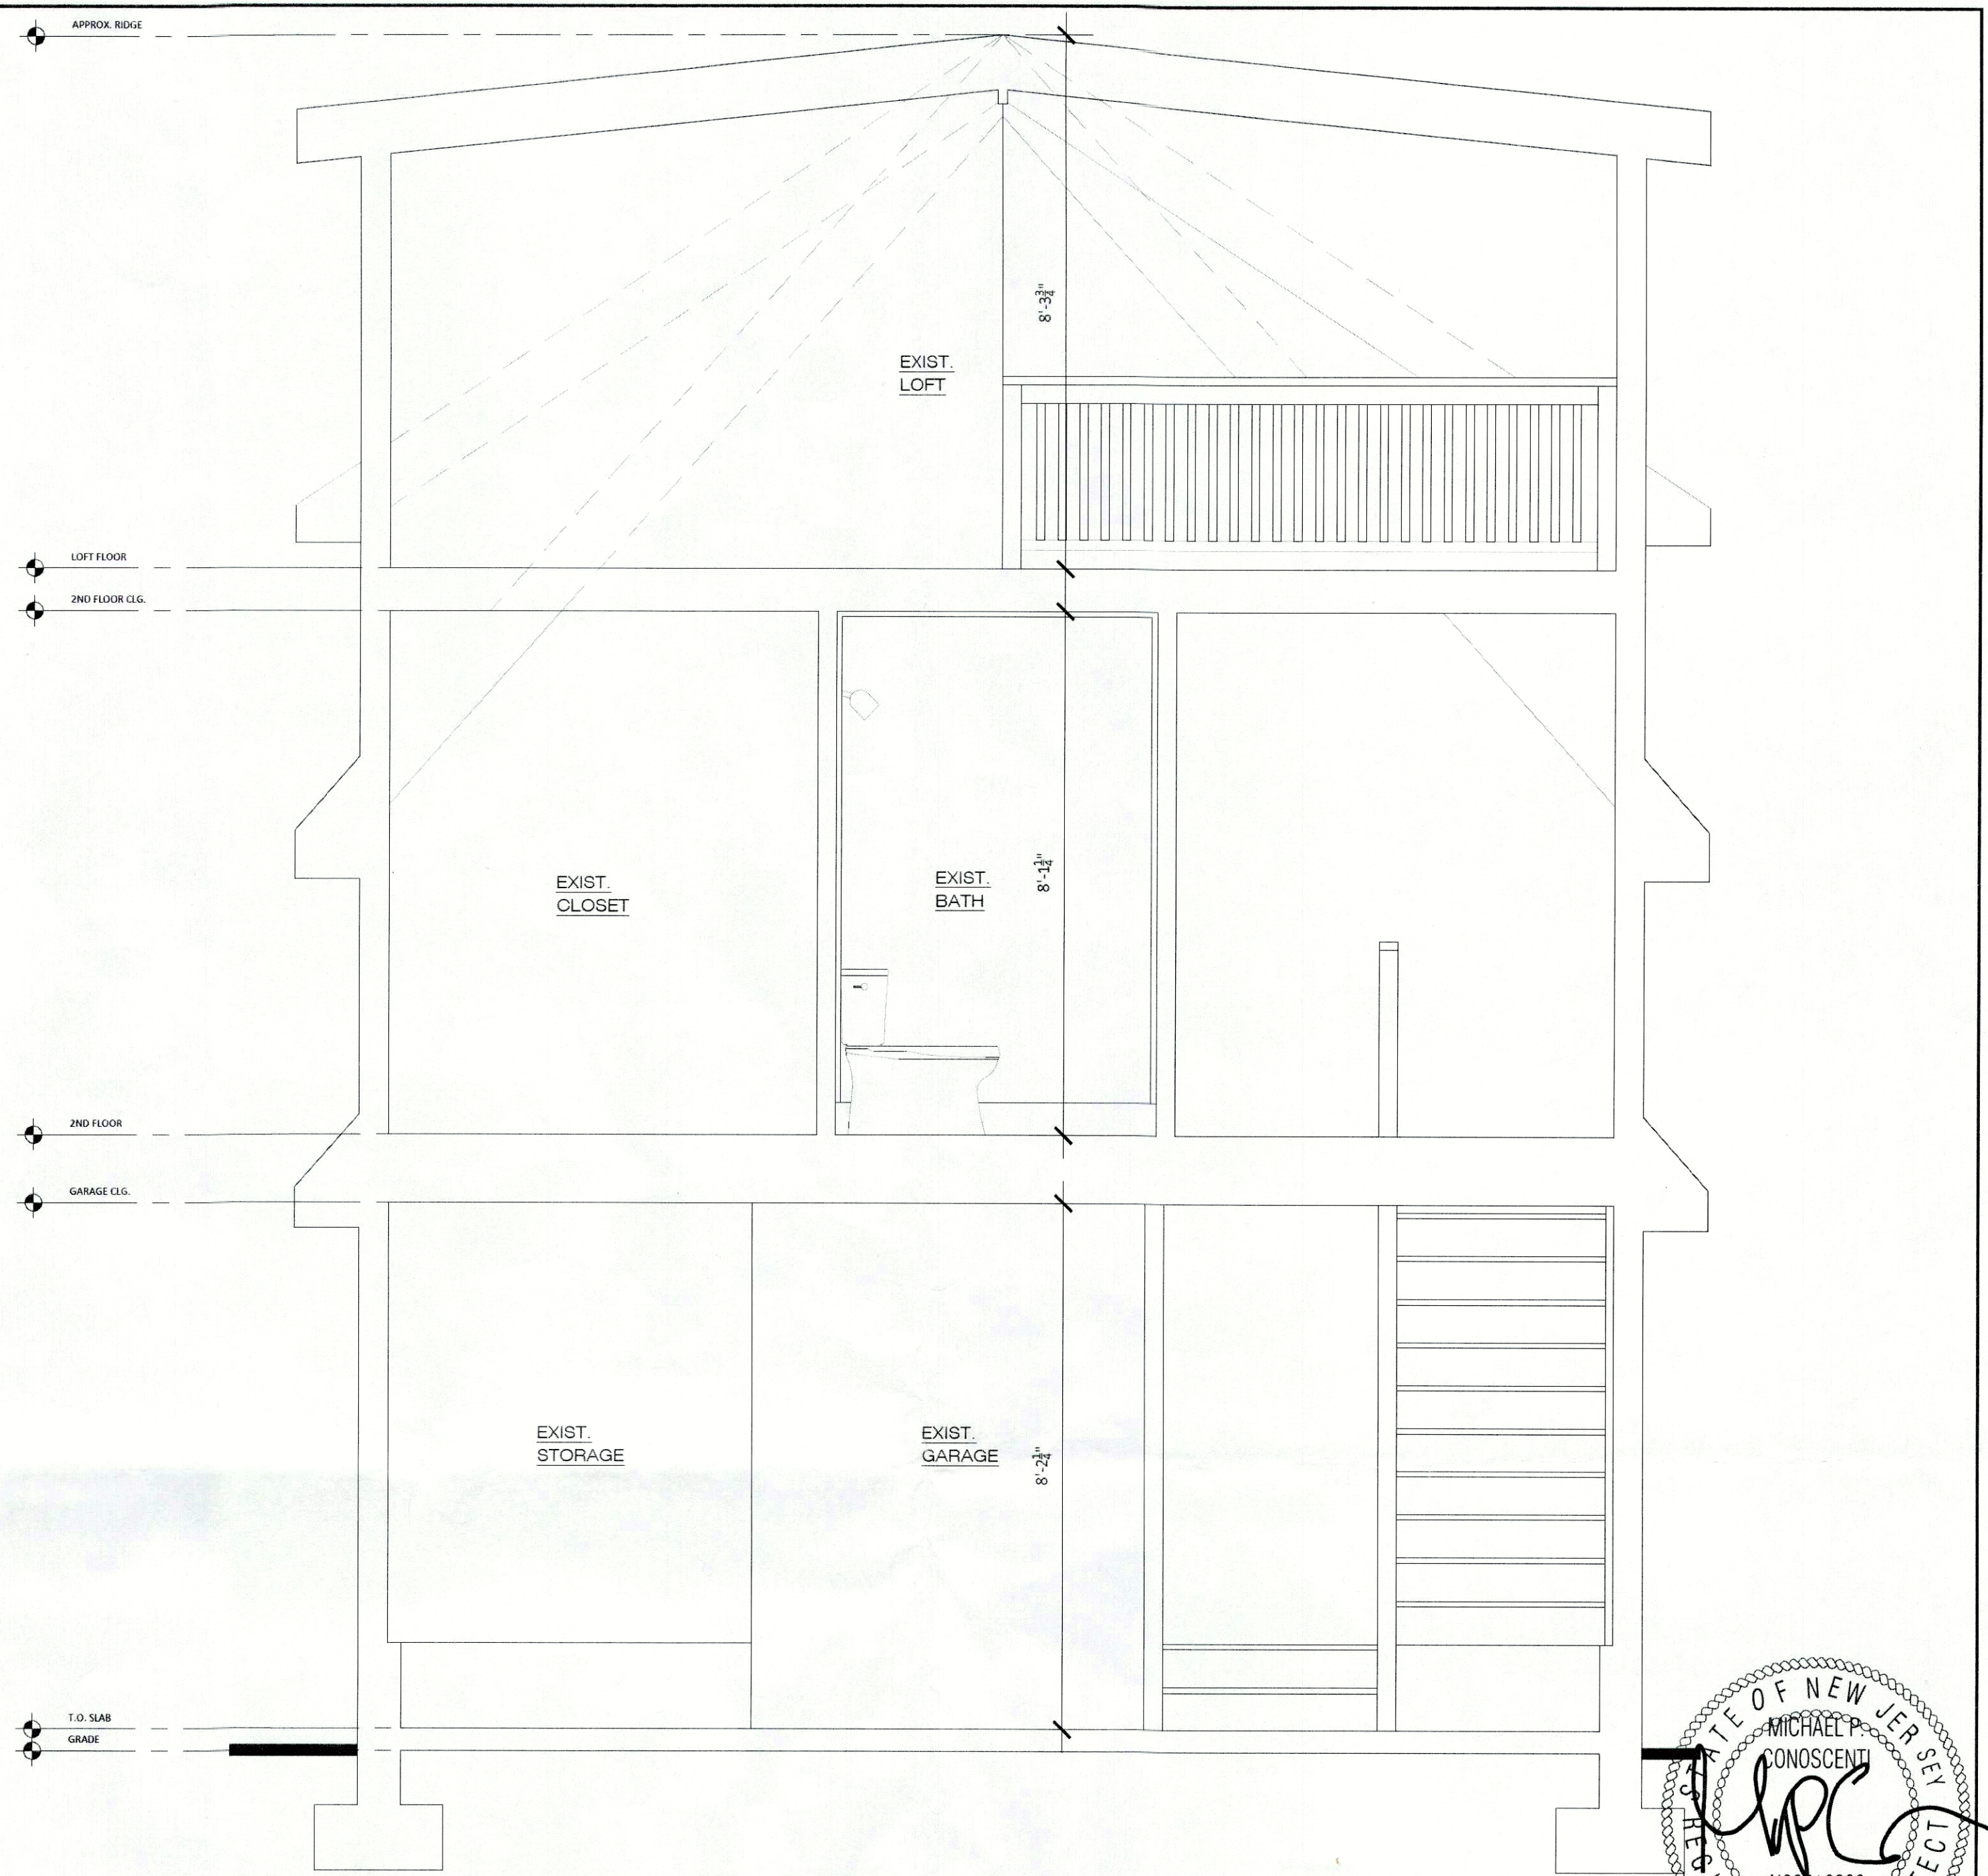

2 CROSS SECTION
 A2 SCALE: 1/4" = 1'-0"

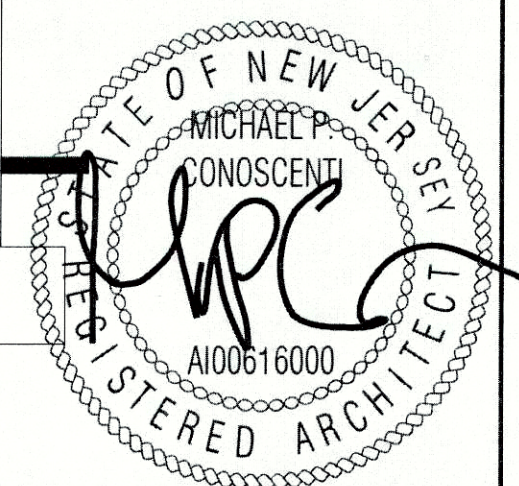

09-15-2019 - ISSUE TO ATTORNEY

MICHAEL P. CONOSCENTI, A.I.A.
 ARCHITECT
 123 CLIFF AVENUE
 BRADLEY BEACH, NJ 07720
 NJ LIC# A100616000

REVISIONS		
No.	DESCRIPTION	DATE

GARAGE: AS-BUILT
 306 MONMOUTH AVE
 BLOCK 78 LOT 14
 BOROUGH OF BRADLEY
 BEACH, MONMOUTH
 COUNTY, NJ

AS-BUILT SECTIONS

PROJECT NO: 18-025
 DATE: AUGUST 19, 2019
 DRAWN BY: ESG
 CHECKED BY: MPC

A2

SCALE: AS NOTED