




1 GARAGE LEVEL
1/4" = 1'-0"

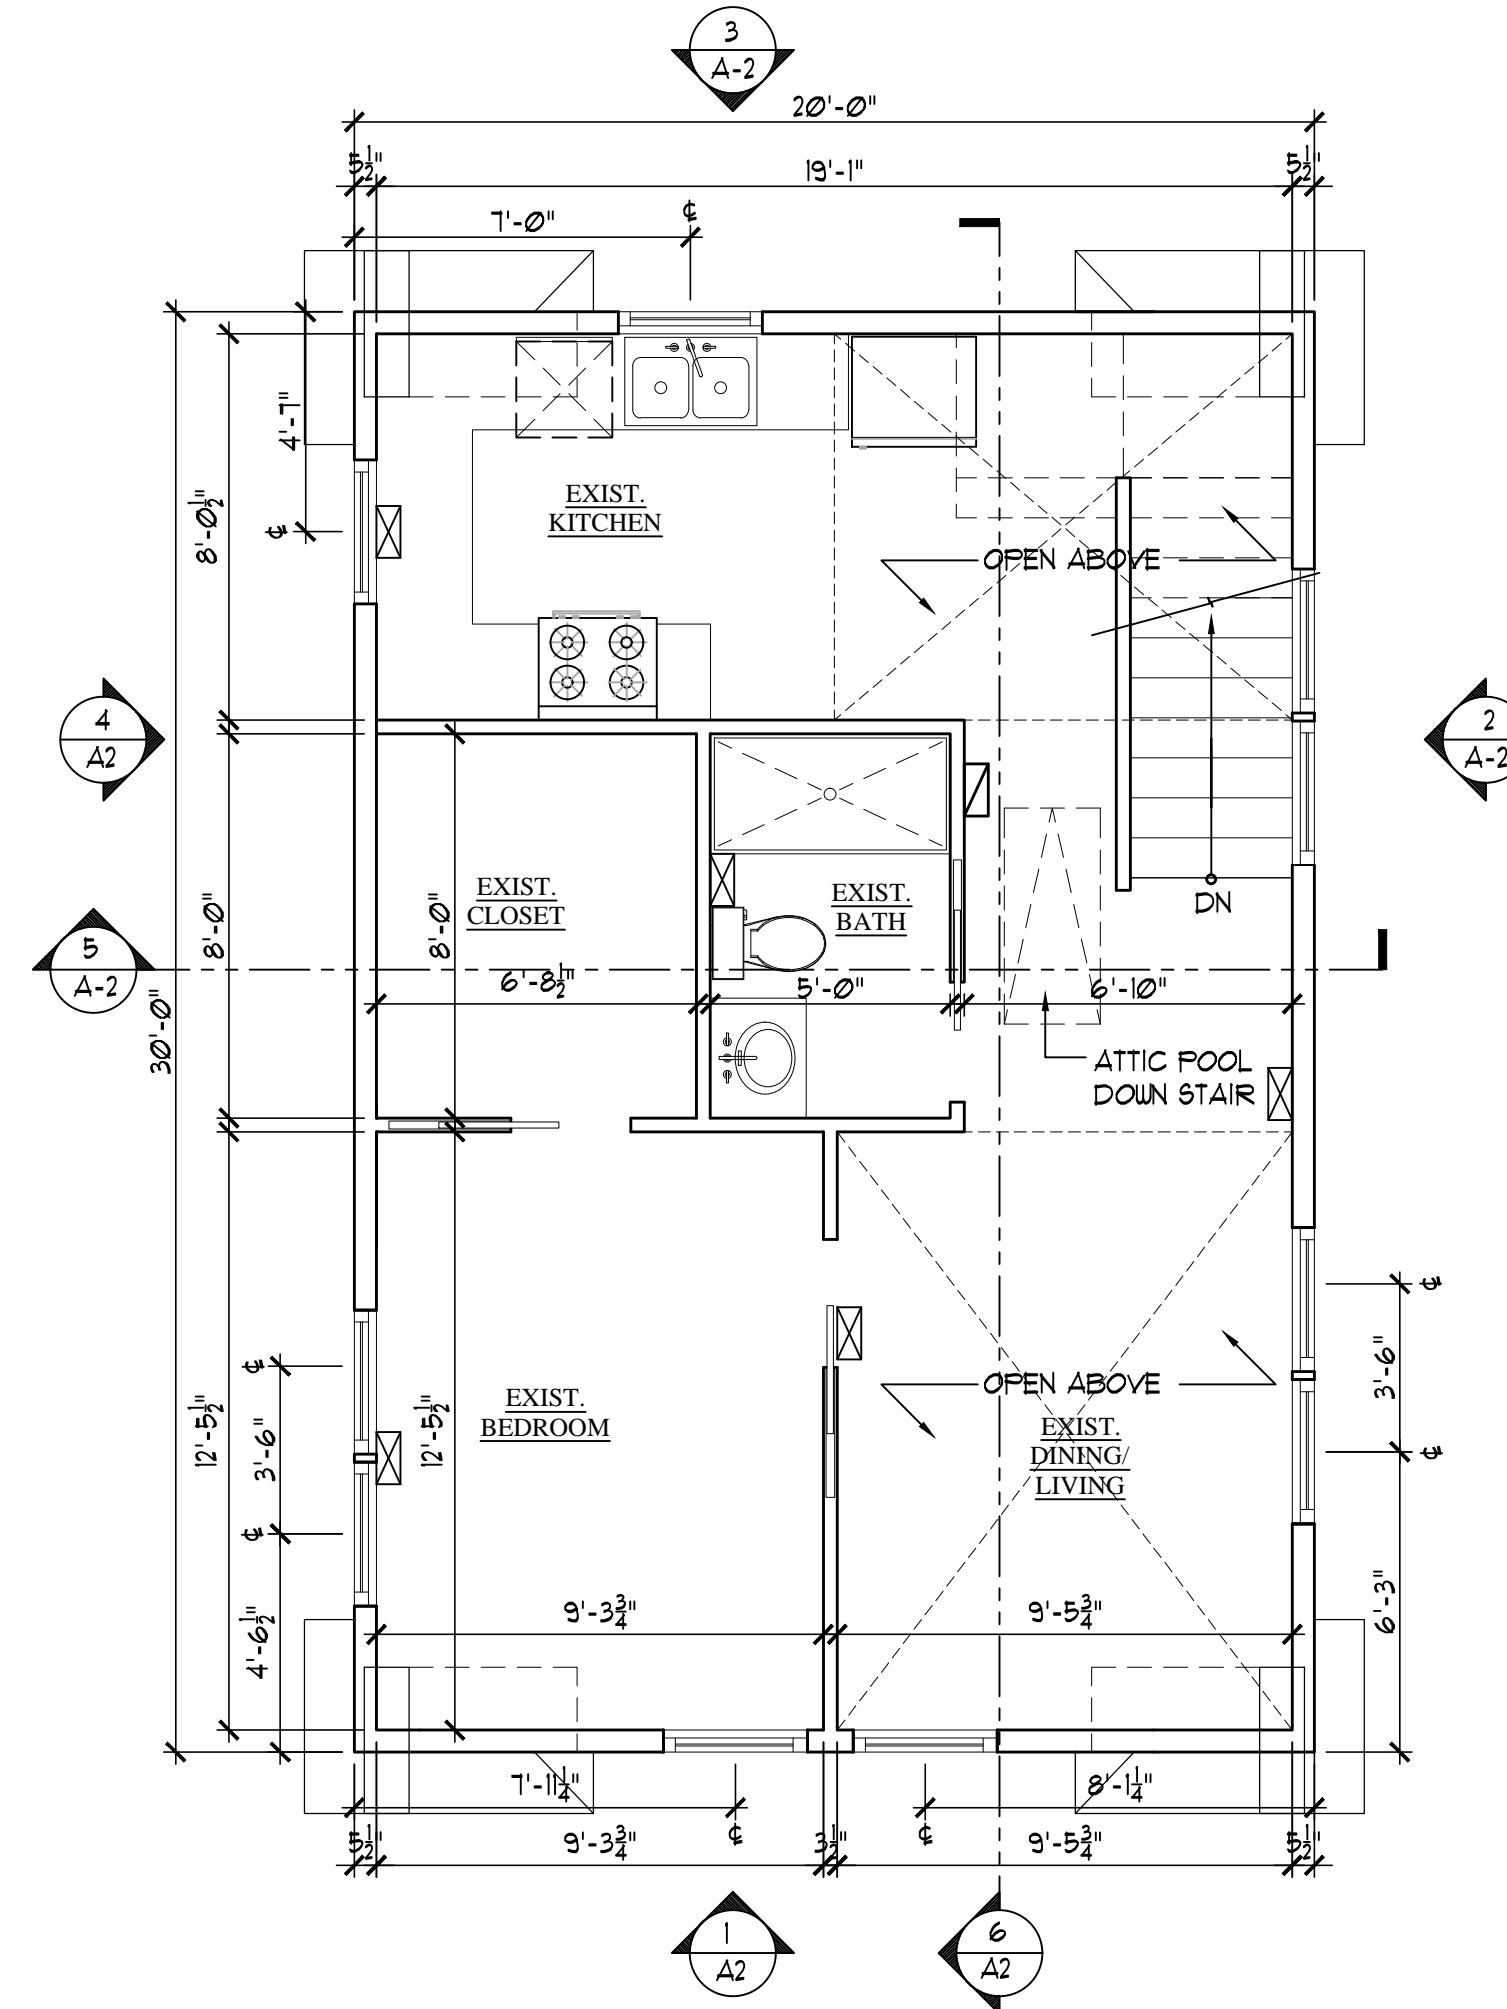

2 2ND FLOOR PLAN
1/4" = 1'-0"

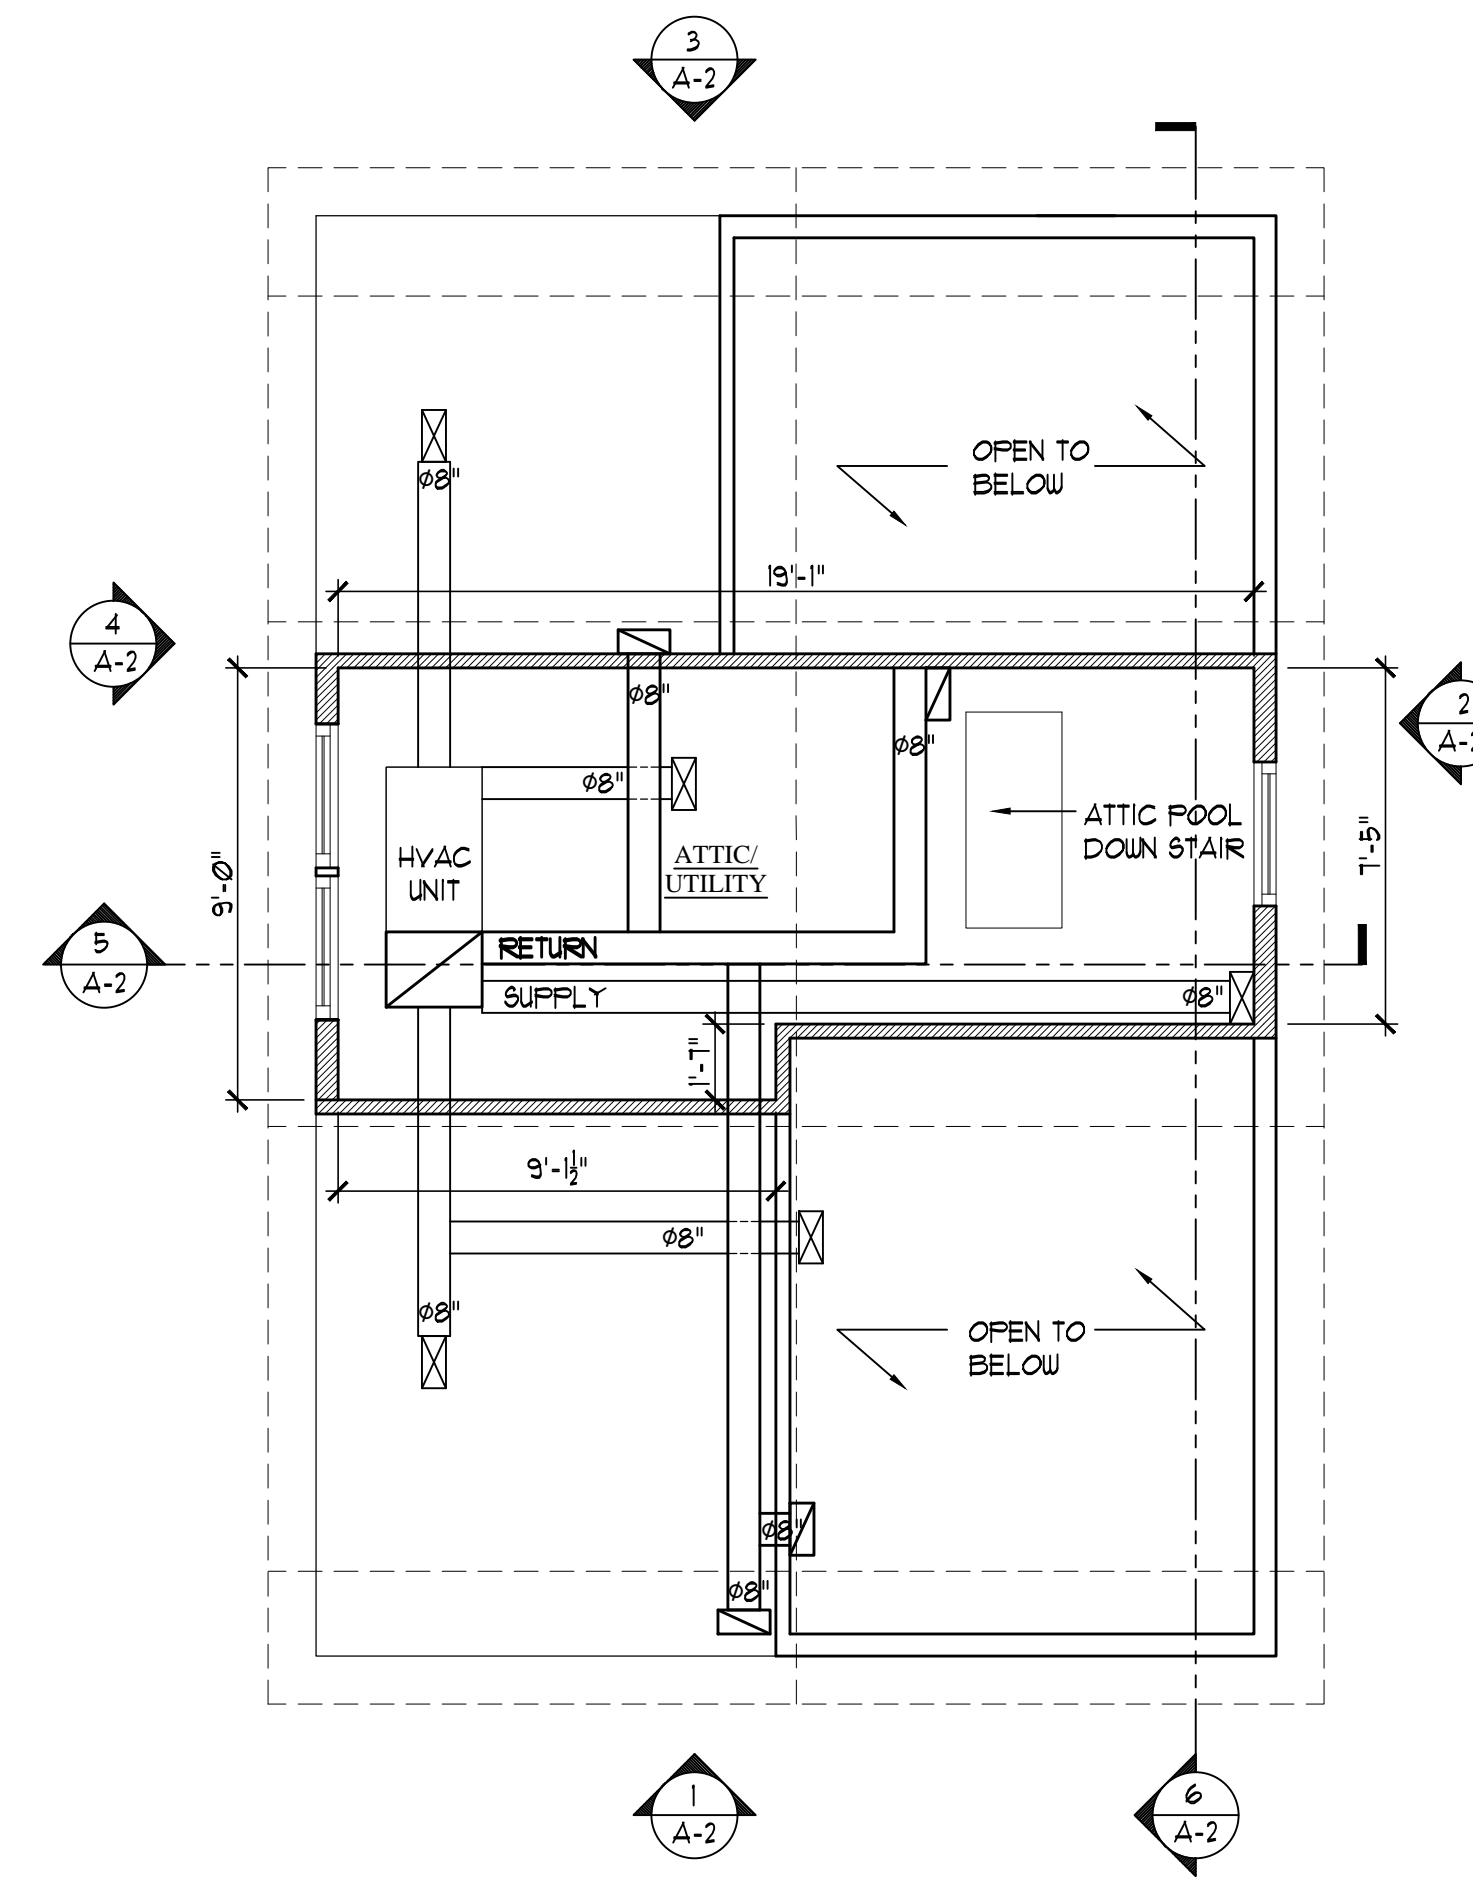

3 ATTIC FLOOR PLAN
1/4" = 1'-0"

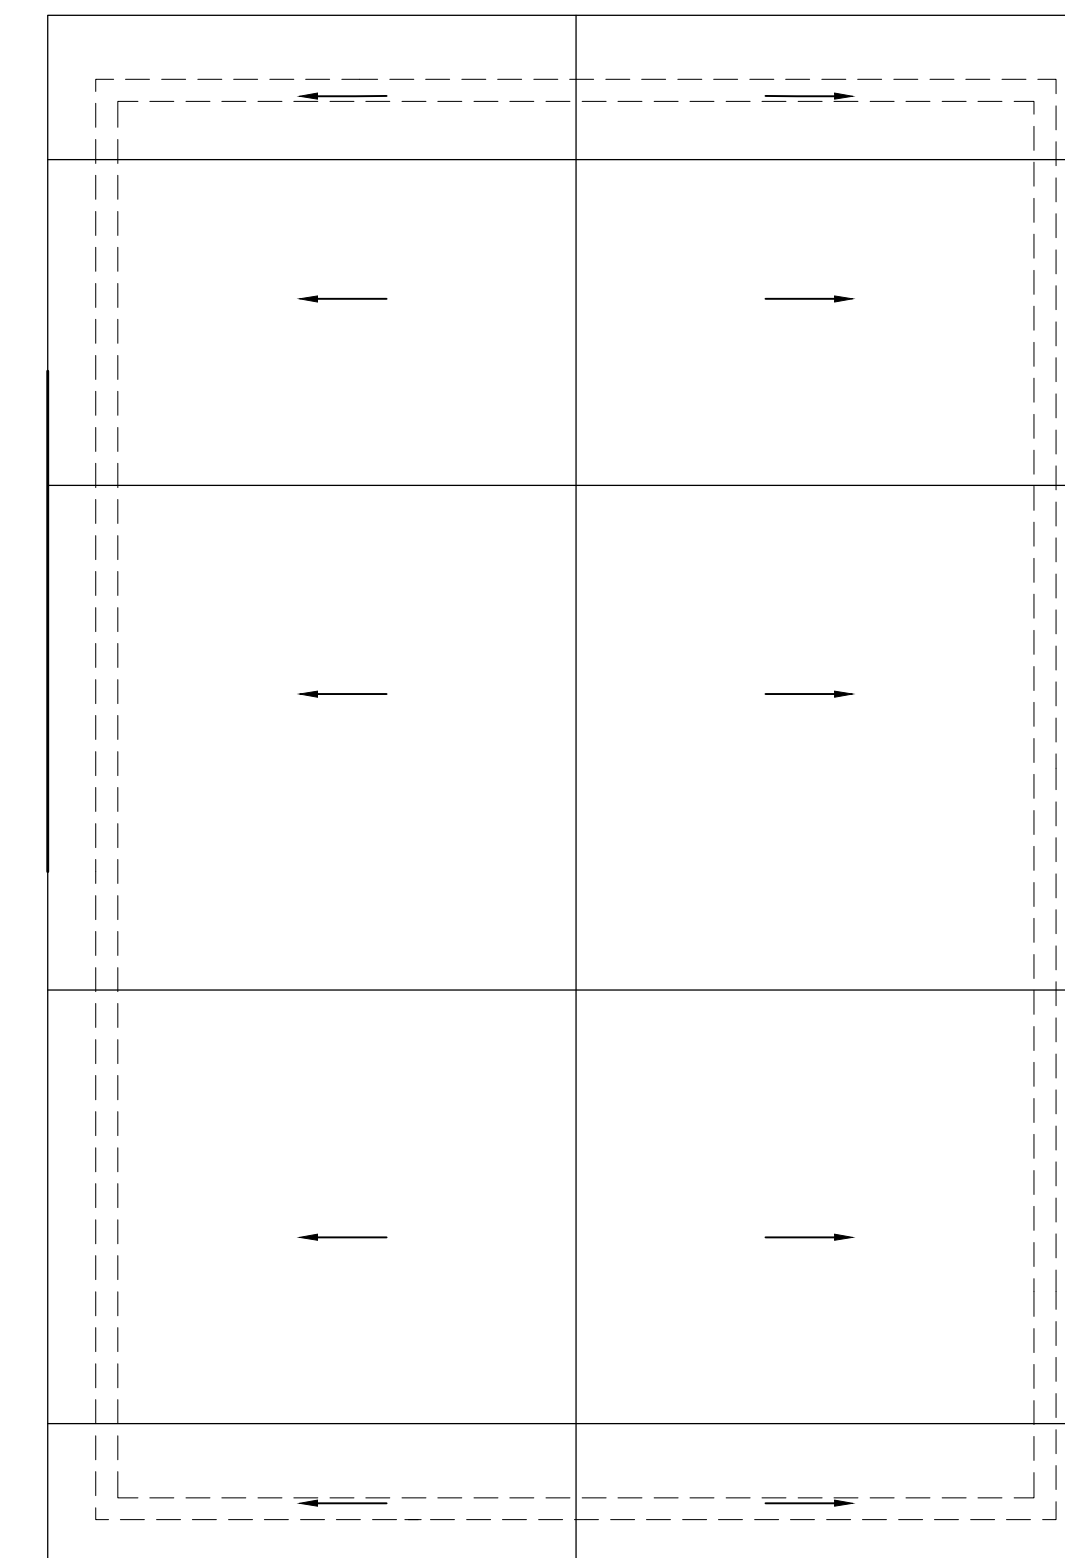

4 ROOF PLAN AS-BUILT
1/4" = 1'-0"



Alfredo R. Trevino
Architect
690 LAWRENCEVILLE ROAD
LAWRENCEVILLE, NJ 08648
TEL. 609-902-3356

CONSULTANT:

SEAL:

PROJECT NAME AND ADDRESS:

AS BUILT CONSTRUCTION
306 MONMOUTH AVE
BLOCK 78 LOT 04
BRADLEY BEACH, NJ 07720

C

This plan is the property of
Alfredo R. Trevino AIA Architect.
No part of this drawing may be
reproduced or forwarded in any
form or by any electronic or
mechanical means without the
written consent of Alfredo R.
Trevino AIA

Revision/Issue

ISSUED FOR PERMIT:
10-28-2020_FLOOR PLAN

DATE: 10-28-2020


DRAWN BY: SVM

JOB NUMBER: 74-20


TITLE:
FLOOR PLANS

Sheet Number:


A-1

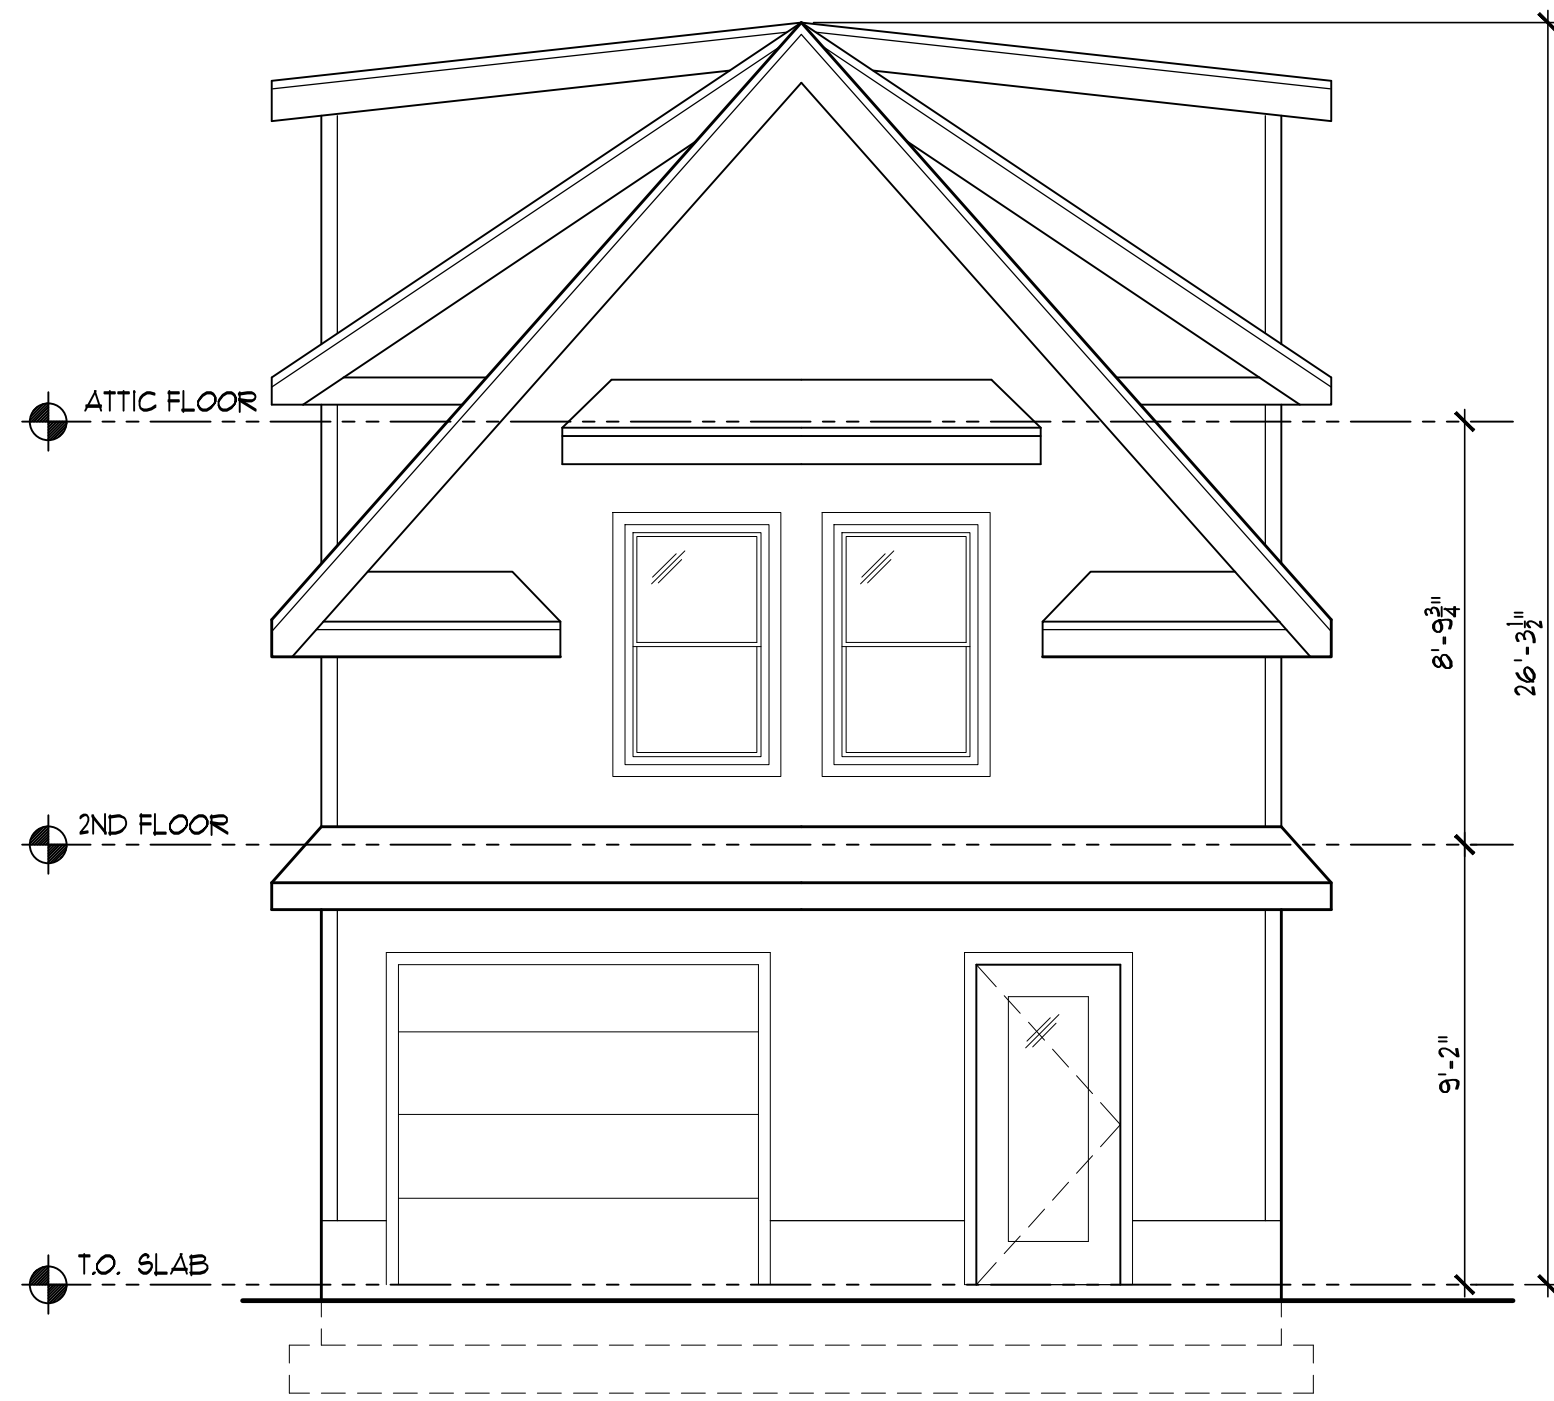


1 SOUTH ELEVATION
1/4" = 1'-0"

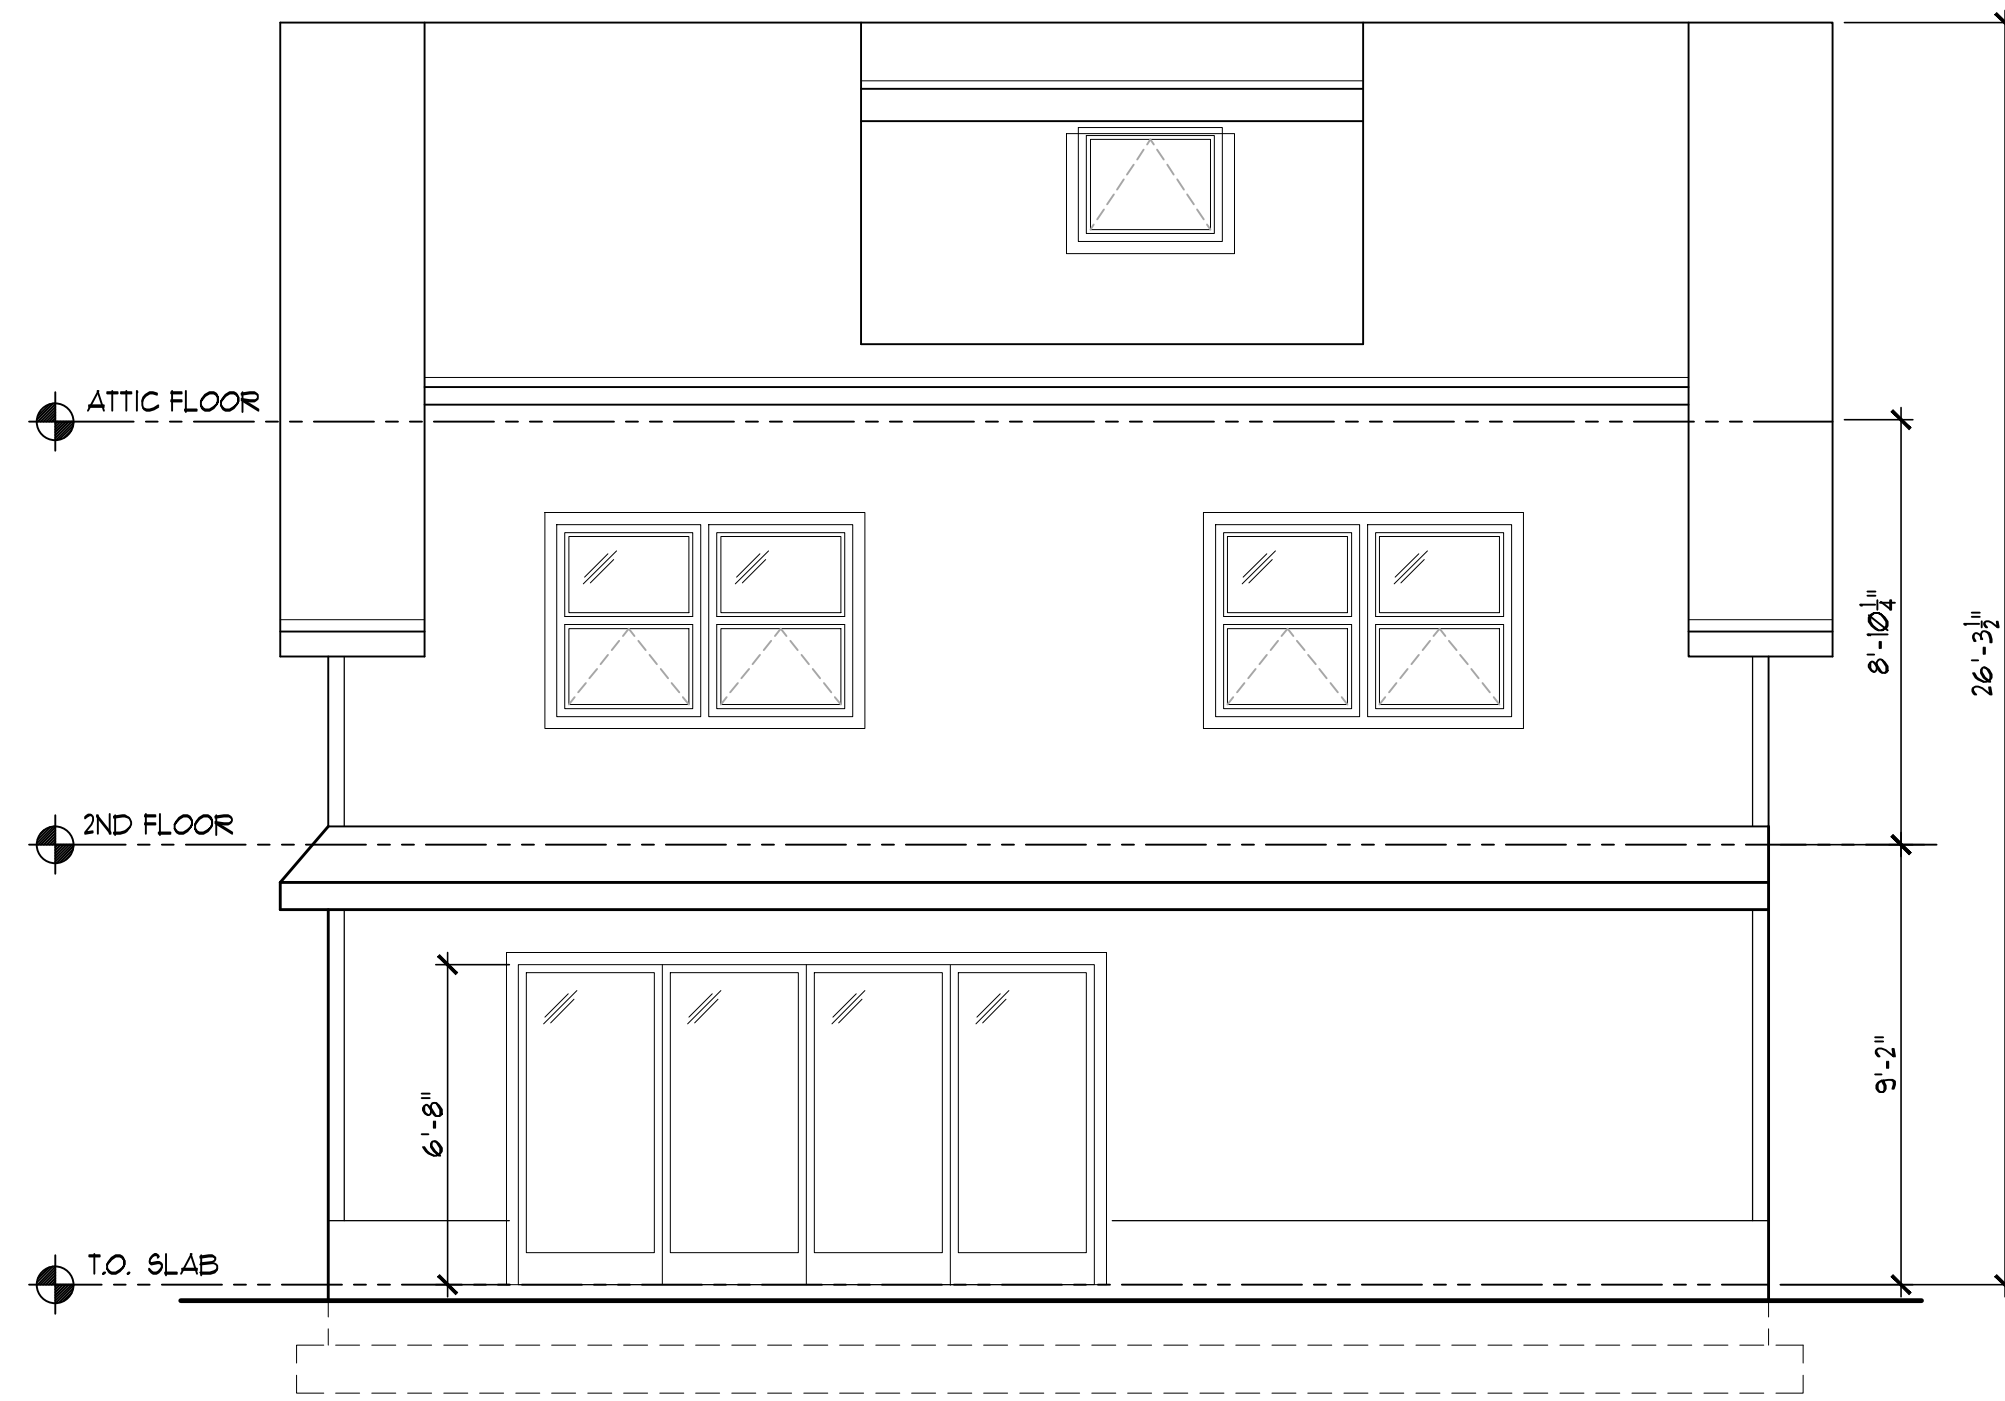


2 EAST ELEVATION
1/4" = 1'-0"

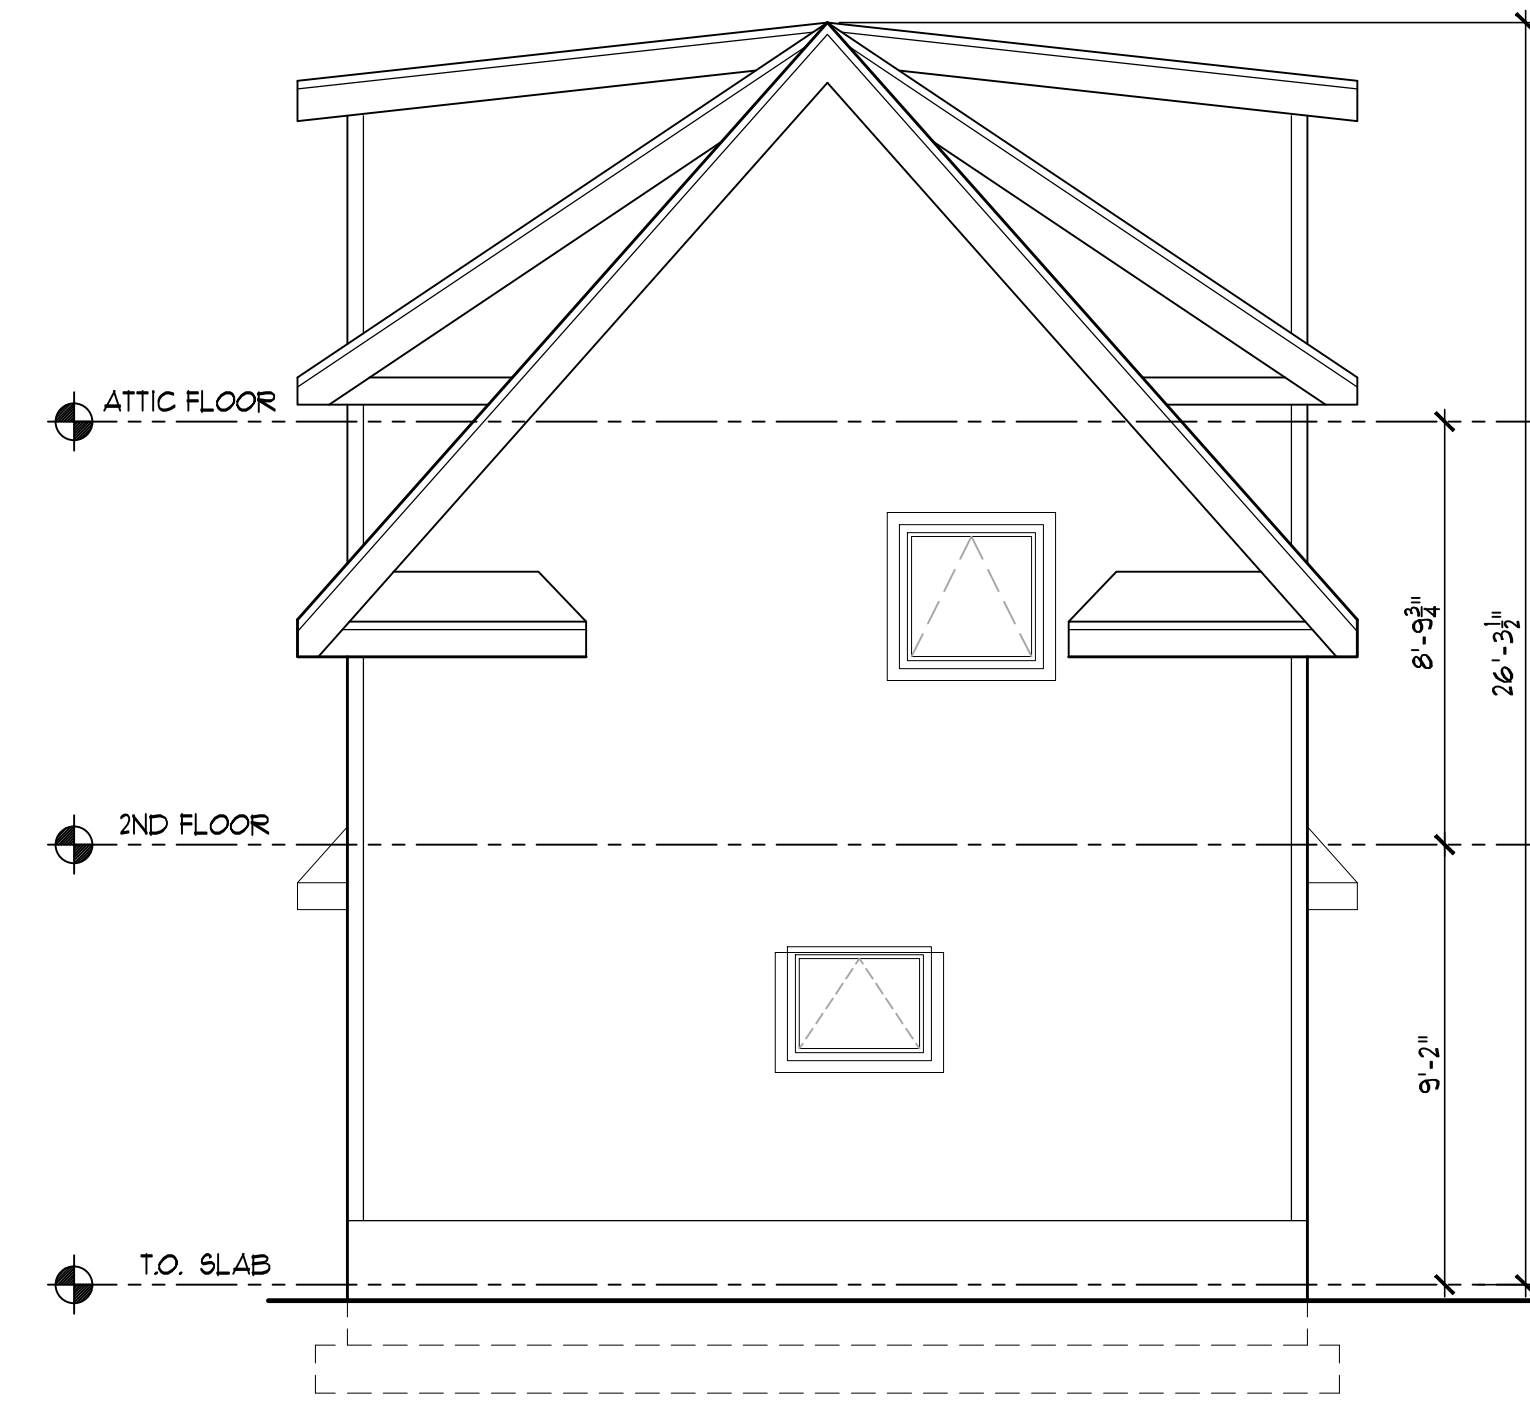

3 NORTH ELEVATION
1/4" = 1'-0"

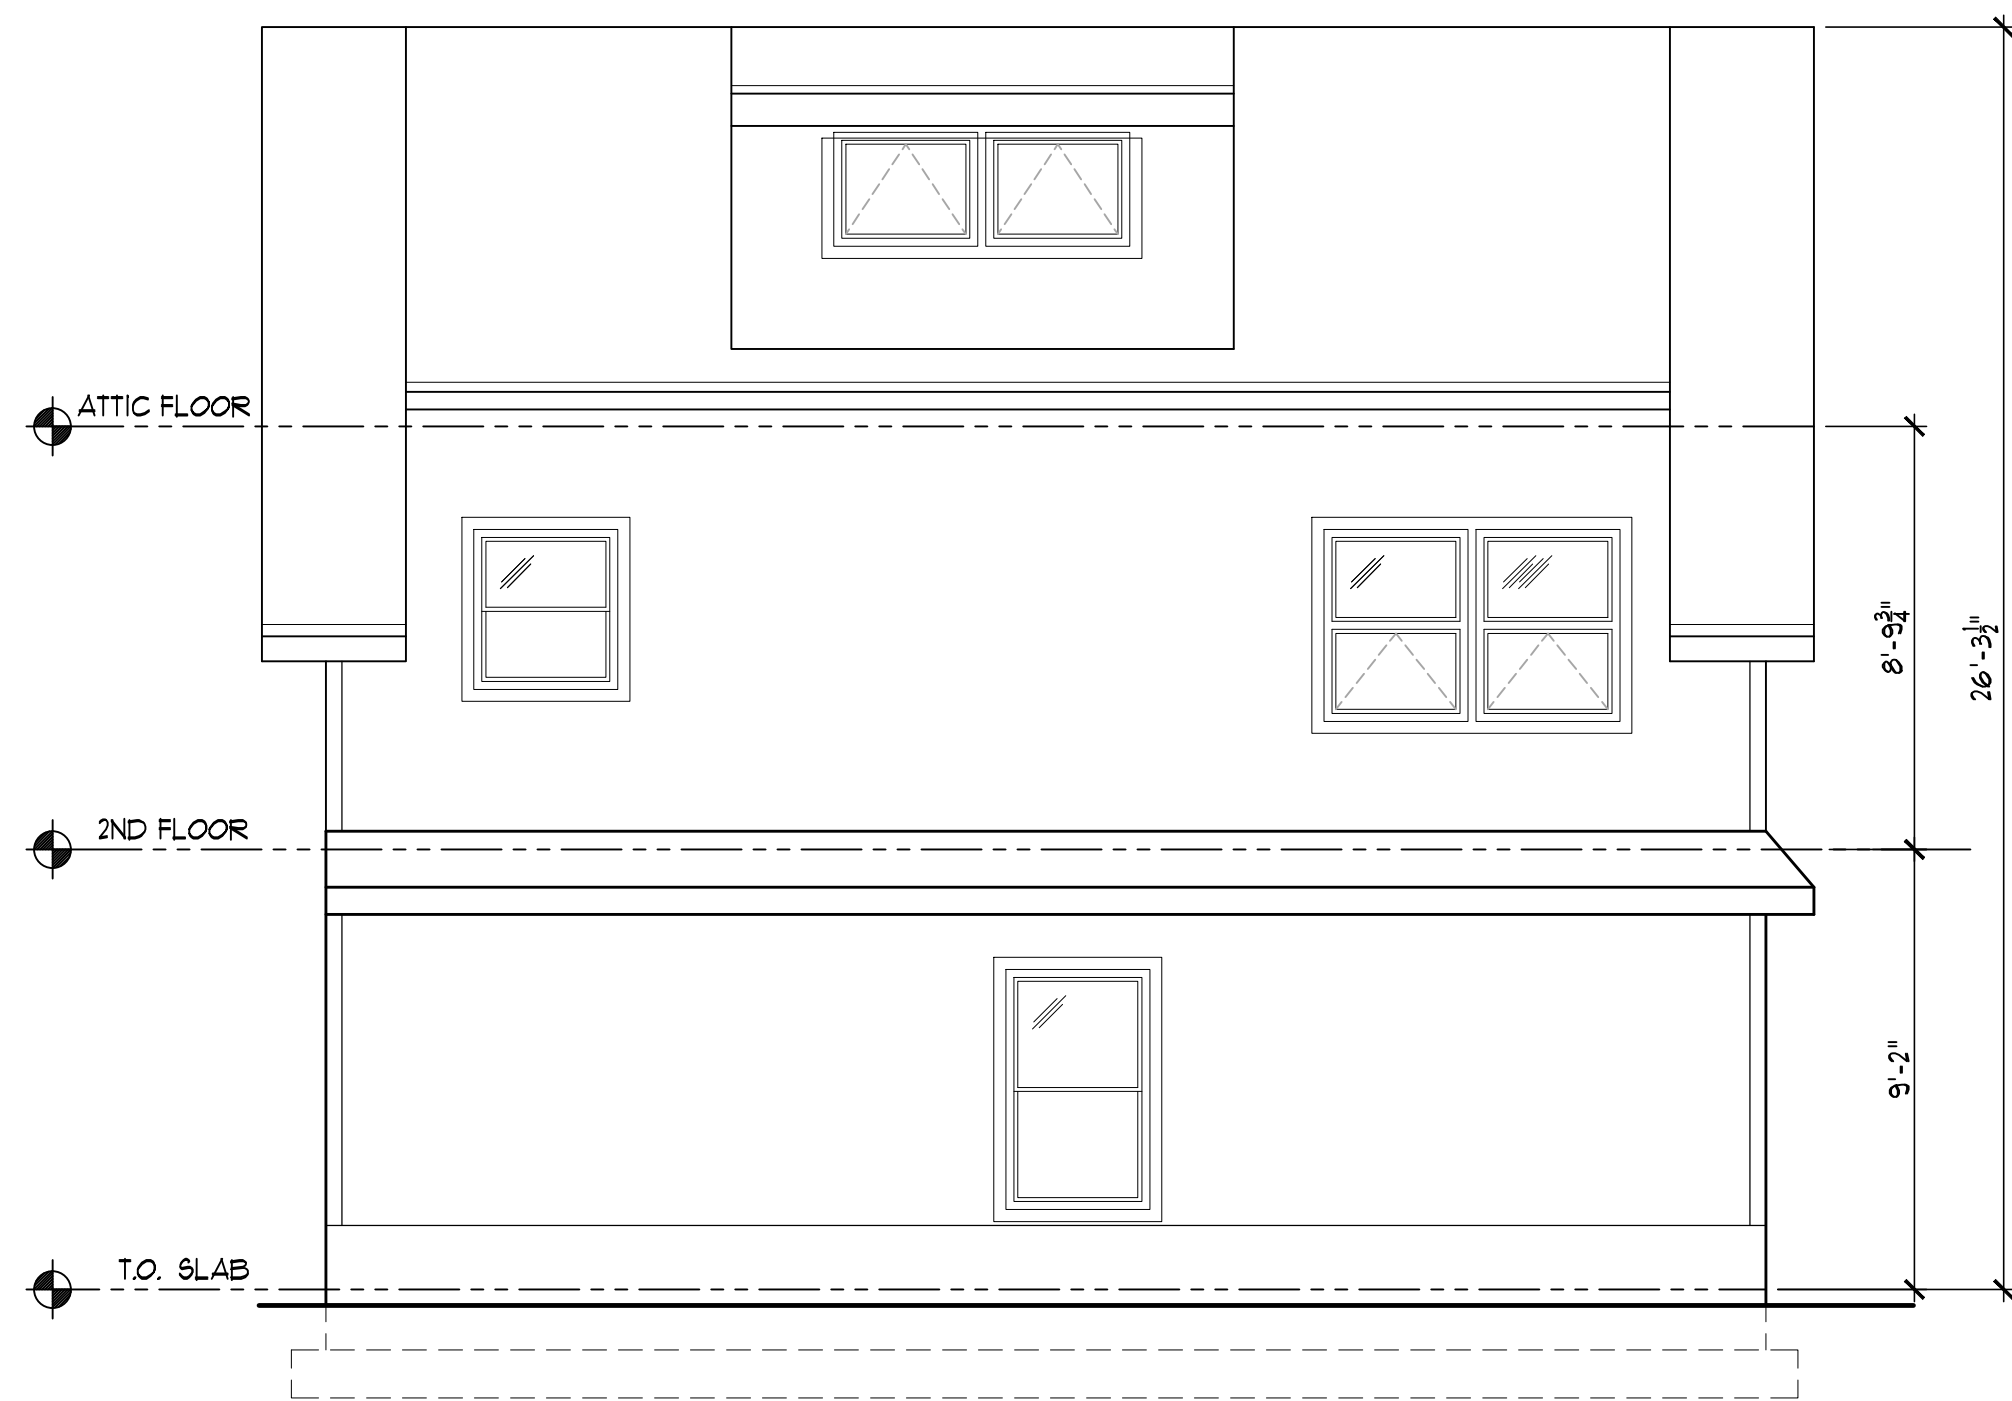

4 WEST ELEVATION
1/4" = 1'-0"

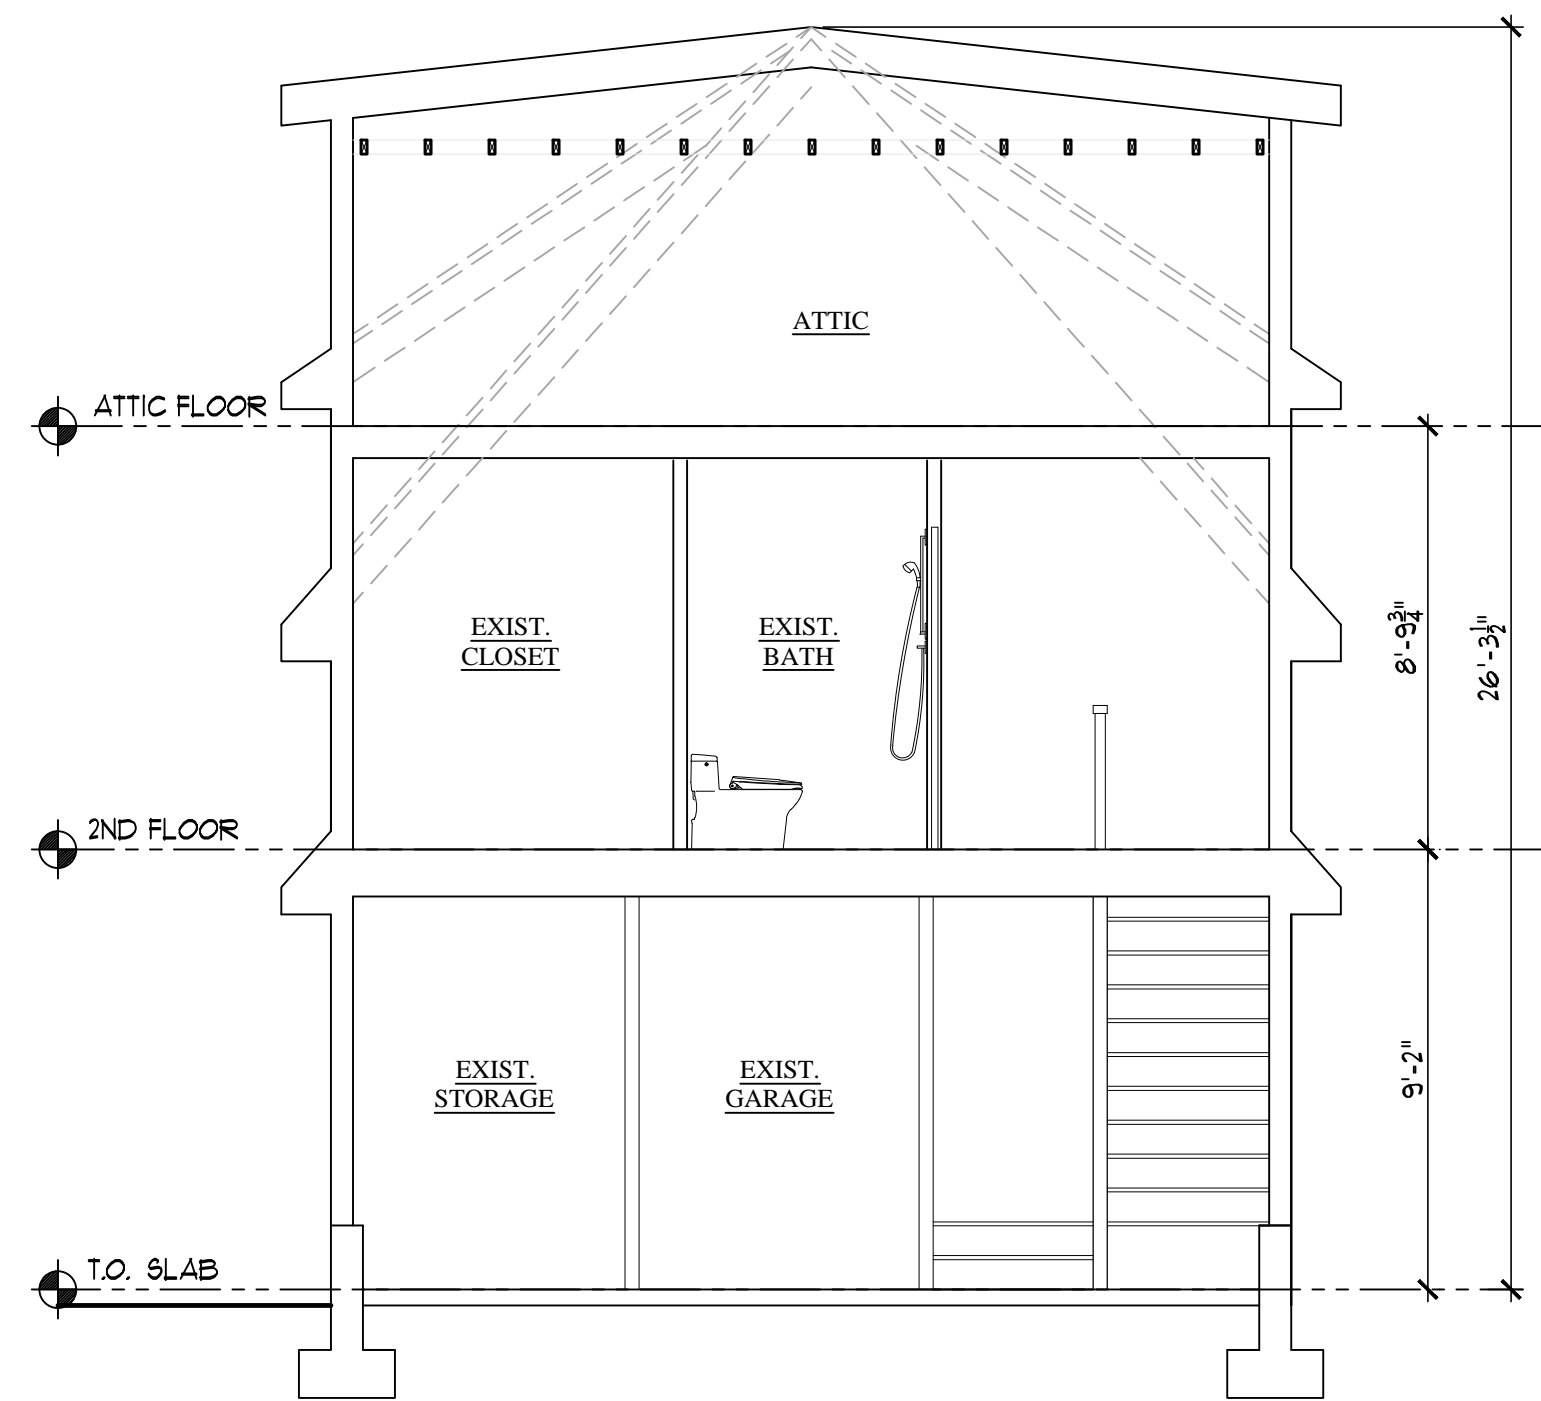

5 CROSS SECTION
1/4" = 1'-0"



6 LONGITUDINAL SECTION
1/4" = 1'-0"



Alfredo R. Trevino
Architect
690 LAWRENCEVILLE ROAD
LAWRENCEVILLE, NJ 08648
TEL. 609 902-3356

CONSULTANT:

SEAL:

PROJECT NAME AND ADDRESS:

AS BUILT CONSTRUCTION
306 MONMOUTH AVE
BLOCK 78 LOT 04
BRADLEY BEACH, NJ 07720

C

This plan is the property of Alfredo R. Trevino AIA Architect. No part of this drawing may be reproduced or forwarded in any form or by any electronic or mechanical means without the written consent of Alfredo R. Trevino AIA

Revision/Issue

ISSUED FOR PERMIT:
10-28-2020_FLOOR PLAN

DATE: 10-28-2020

DRAWN BY: SVM

JOB NUMBER: 74-20

TITLE:
ELEVATIONS & SECTIONS

Sheet Number:

A-2